IREDELL COUNTY HEALTH DEPARTMENT

Authorization to Construct

STATESVILLE 704-878-5305 MOORESVILLE 704-664-5281

IMPROVEMENT PERMIT / ~~CERTIFICATE OF COMPLETION~~ / OPERATION PERMIT / EXISTING SYSTEM INSPECTION

PROPERTY DESCRIPTION NO. 23209 DATE 6/11/96 TAX MAP NO. pt of 25A80 Watershed: ☑ Yes ☐ No

OWNER OR CONTRACTOR Van Edward Const. PHONE: Business 664-7630 ~~Home~~ 4638-79-4002

ADDRESS 150 Rocky River Rd.

LOCATION 150 W-TR Perth Rd - TL Stumpy Creek Rd - lt on left

SUBDIVISION Harborview BLOCK / SECTION II LOT 5 LOT AREA .56ac SITE CLASS. PS DESIGN FLOW 360gpd L.T.A.R. .3 gpd/sf

Septic Tank: 1000 Gallons; STB 794 Date 11-1-96

Pump Tank: _____ Gallons; PT _____ Date _____

Pump Make: _____ Model _____ Serial No. _____

Nitrification Field: No Fields 1 Square Feet 1400 Linear Feet 400

No Lines 4 @ 100' Trench Width 36 Max Trench Bottom Depth ≈ 24" Gravel Depth 12"

☑ New System ☐ Repair System Type: I (II) III, IV, V, VI

System Description: Gravity Conventional

Repair System Description: Gravity/Pump Conv.

Maintenance Agreement Required: ☐ Yes ☑ No

☑ House/Mod. Home ☐ Mobile Home ☐ Business ☐ Other

No. Bedrooms 3 No. Bathrooms 2.5 No. Employees _____


☐ Slab ☑ Crawl Space ☐ Basement w/plumbing ☐ Basement wo/plumbing

Water Supply: ☐ Individual ☑ Community ☐ Public

Comments:

Comments:

INITIAL SITE SKETCH 1"=60'

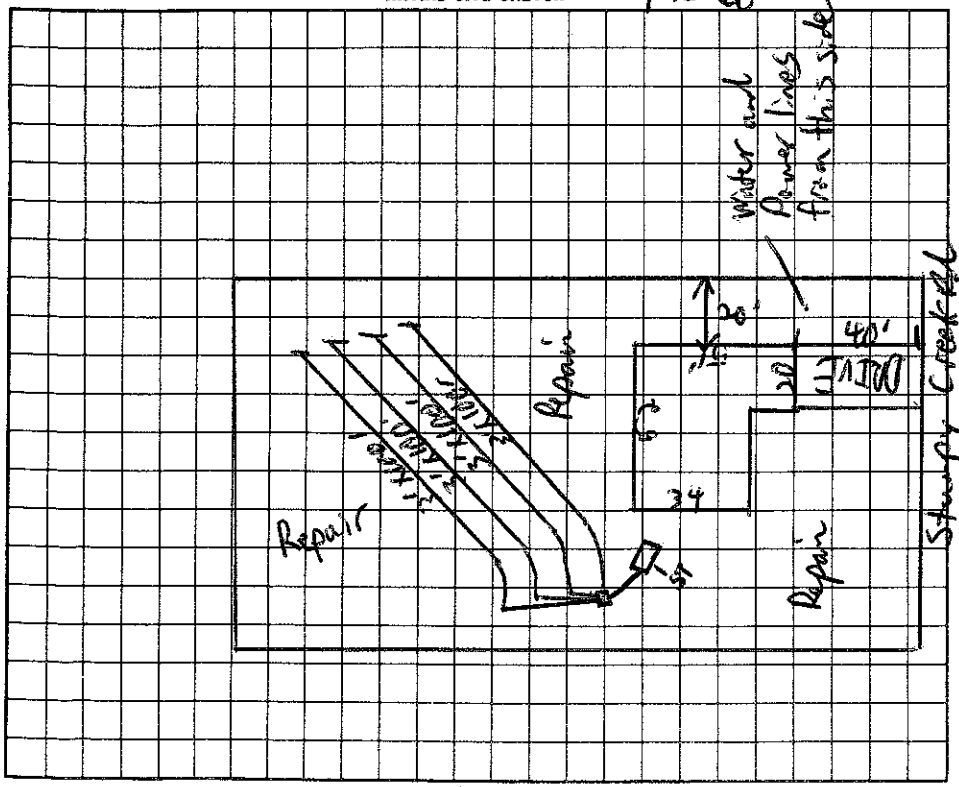

AS BUILT SKETCH

I understand that this permit can be suspended or revoked if any false information is supplied toward securing the permit/any unauthorized changes are made to the site/any unauthorized changes are made in the installation of the system.

Signed: Van Edward Contracting Corp. by Tracy P. VanDeusen Soc Installed by: LARRY BEAM

Improvement Permit by: C. Ruby Thomas EHSI date 6/11/96

Authorization to Const. ~~Existing System Inspection~~ by: C. Ruby Thomas EHSI date 6/11/96

Certificate of Completion by: _____ date _____

Operation Permit by: C. Ruby Thomas EHSI date 12/23/96

HEALTH DEPT. COPY: WHITE INSPECTION COPY (FINAL): GREEN OWNER COPY (FINAL): YELLOW INSPECTION COPY (INITIAL): PINK OWNER COPY (INITIAL): GOLD

Authorization to Construct is valid for 60 months from issue date