IREDELL COUNTY HEALTH DEPARTMENT

STATESVILLE 704-878-5305 MOORESVILLE 704-664-5281

IMPROVEMENT PERMIT / ~~CERTIFICATE OF COMPLETION~~ / OPERATION PERMIT / EXISTING SYSTEM INSPECTION

PROPERTY DESCRIPTION NO. 23208 DATE 6/11/96 TAX MAP NO. pt of 25 A80 Watershed: ☑ Yes ☐ No

OWNER OR CONTRACTOR Van Edmond Const. PHONE: Business 664-7630 ~~Home~~ 4638-79-5017

ADDRESS 1450 Rocky River Rd

LOCATION 150' W TR Perth Rd - TL Stumpy Creek Rd on left

SUBDIVISION Harbinrow BLOCK / SECTION II LOT 4 LOT AREA .56 ac SITE CLASS. PS DESIGN FLOW 360 gpd L.T.A.R. .3 gpd/ft2

Septic Tank: 1000 Gallons; STB 744 Date 10/29/96

Pump Tank: _____ Gallons; PT _____ Date _____

Pump Make: _____ Model _____ Serial No. _____

Nitrification Field: No Fields 1 Square Feet 900 Linear Feet 300

No Lines 3 Trench Width 36" Max Trench Bottom Depth ~24" Gravel Depth N/A

☑ New System ☐ Repair System Type: I, II, III, IV, V, VI

System Description: Gravity Chamber

Repair System Description: Gravity / Pump Chamber

Maintenance Agreement Required: ☐ Yes ☑ No

☑ House/Mod. Home No. Bedrooms 3

☐ Mobile Home No. Bathrooms 2.5

☐ Business No. Employees ____

☐ Other _____


☐ Slab ☑ Crawl Space ☐ Basement w/plumbing ☐ Basement wo/plumbing

Water Supply: ☑ Individual ☑ Community ☐ Public


Comments: 6 11 → 75

Comments:

INITIAL SITE SKETCH 1"=60'

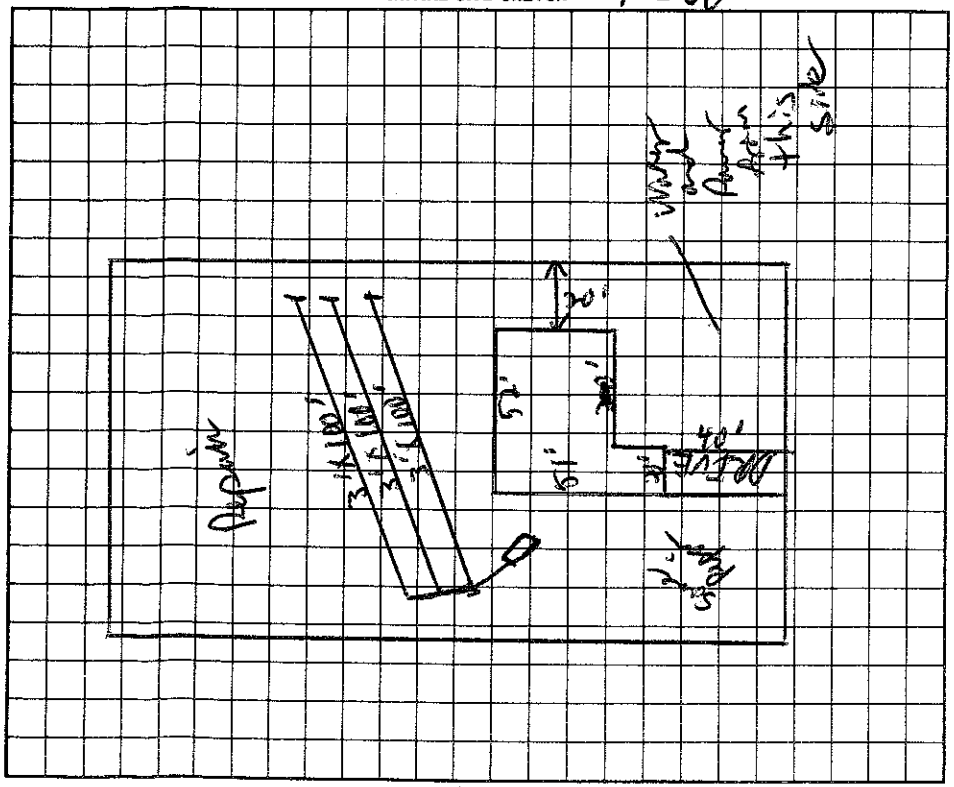

AS BUILT SKETCH

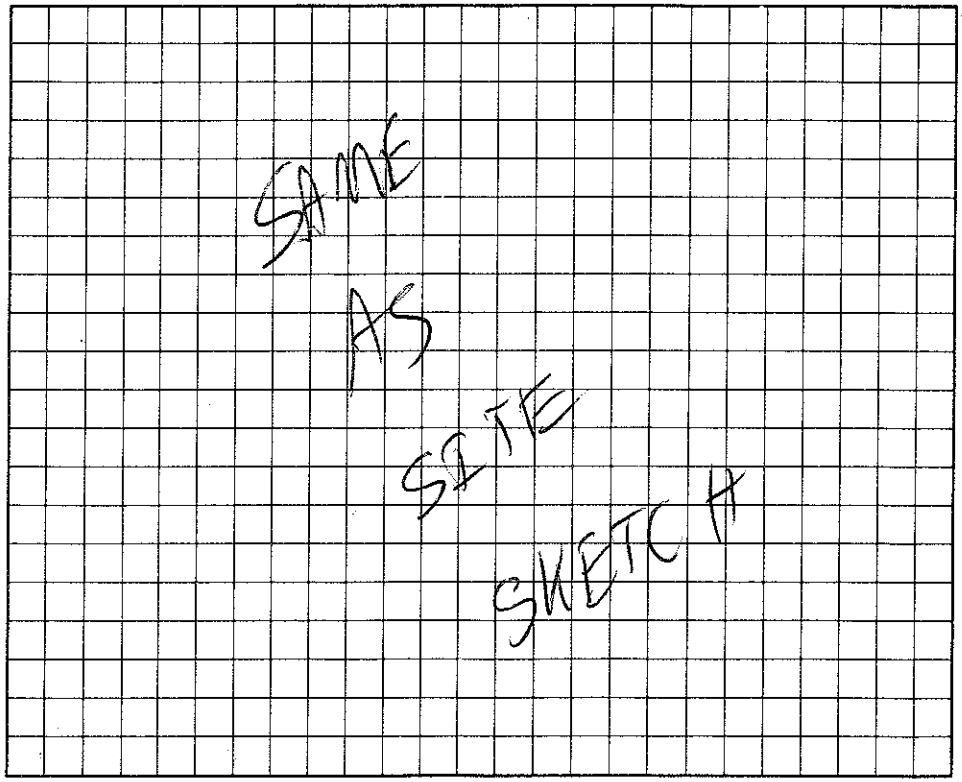

I understand that this permit can be suspended or revoked if any false information is supplied toward securing the permit/any unauthorized changes are made to the site/any unauthorized changes are made in the installation of the system.

Signed: VanEdmond Contracting, Const. by Tracy B VanDerlin Sec. Installed by: LARRY BEAM

Improvement Permit by: C. Buck Foster EHSI date 6/11/96 Certificate of Completion by: _____ date _____

Authorization to Construct ~~Existing System Inspection~~ by: C. Buck Foster EHSI date 6/11/96 Operation Permit by: C. Buck Foster EHSI date 12/27/96

HEALTH DEPT. COPY: WHITE INSPECTION COPY (FINAL): GREEN OWNER COPY (FINAL): YELLOW INSPECTION COPY (INITIAL): PINK OWNER COPY (INITIAL): GOLD

Authorization to Construct is valid for 60 months from issue date