(3.00)

IREDELL COUNTY HEALTH DEPARTMENT Const. Auth. STATESVILLE 704-878-5305 MOORESVILLE 704-664-5281

IMPROVEMENT PERMIT / ~~CERTIFICATE OF COMPLETION~~ / OPERATION PERMIT / EXISTING SYSTEM INSPECTION

PROPERTY DESCRIPTION NO. 23207 DATE Sept 3, '96 TAX MAP NO. part of 25A80 Watershed: ☑ Yes ☐ No

OWNER OR CONTRACTOR James M. Harper PHONE: Business ~~Home~~ 4638-79-6121

ADDRESS 1651 Lakefront Dr. Catawba

LOCATION Perth Rd. N. to Stumpy Creek Rd. 3rd Lot on left

SUBDIVISION Harbourview BLOCK / SECTION II LOT 3 LOT AREA 24,380 ft² SITE CLASS. RS DESIGN FLOW 360 gpl L.T.A.R. n.a.3

Septic Tank: 1000 Gallons; STB 786 Date 1/4/97
Pump Tank: ____ Gallons; PT ____ Date ____
Pump Make: ____ Model ____ Serial No. ____
Nitrification Field: No Fields 1 Square Feet 1200 Linear Feet 400
No Lines 4@100' Trench Width 36" Max Trench Bottom Depth ~24" Gravel Depth 12"

☑ New System ☐ Repair System Type: I, II, III, IV, V, VI
System Description: gravity conventional
Repair System Description: gravity conv. / modified
Maintenance Agreement Required: ☐ Yes ☑ No

☑ House/Mod. Home No. Bedrooms 3
☐ Mobile Home No. Bathrooms 2
☐ Business No. Employees ____
☐ Other ____
☑ Slab ☑ Crawl Space ☐ Basement w/plumbing ☐ Basement wo/plumbing


Water Supply:
☐ Individual
☐ Community
☑ Public

Comments:


Comments:

1" = 50'

INITIAL SITE SKETCH

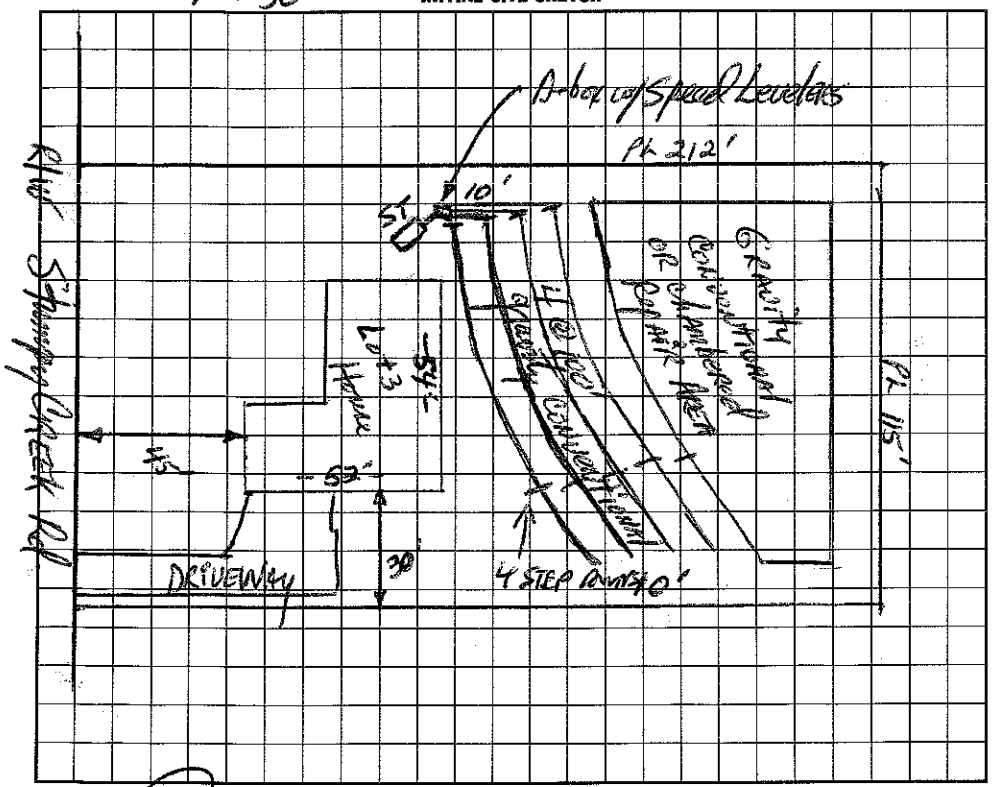

AS BUILT SKETCH

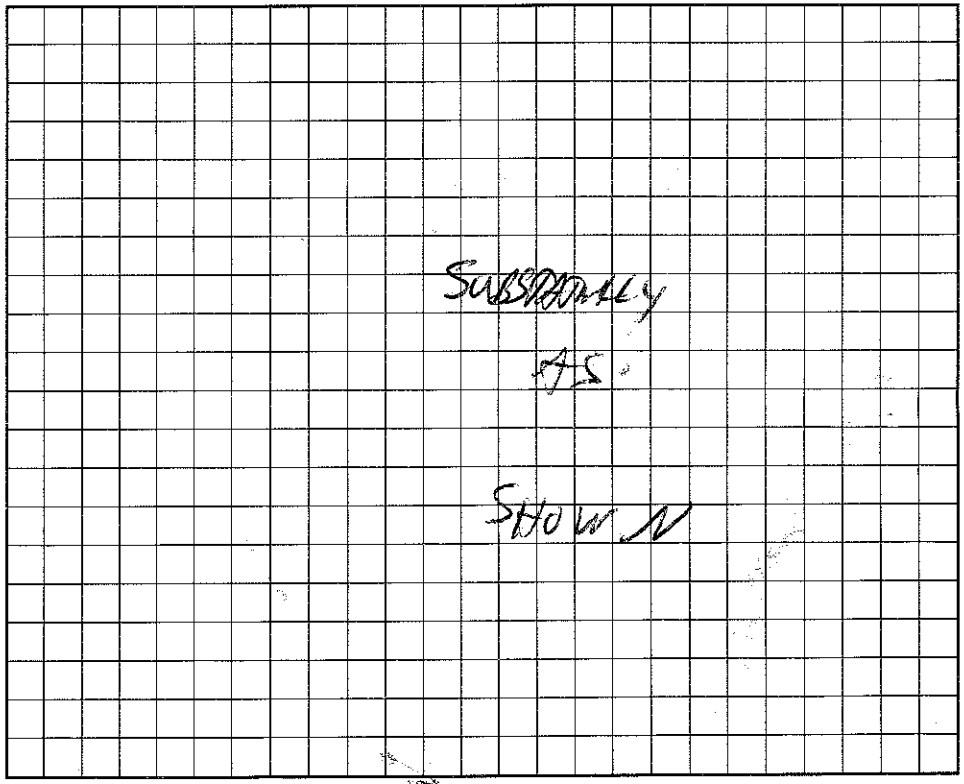

I understand that this permit can be suspended or revoked if any false information is supplied toward securing the permit/any unauthorized changes are made to the site/any unauthorized changes are made in the installation of the system.

Signed: X James M. Harper

Improvement Permit by: R.B. Hamm IRS date 9-3-96

~~Existing system inspection~~ Construction Authorization by: R.B. Hamm IRS date 9-3-96

Installed by: KENNEDY GRADING

Certificate of Completion by: ____ date ____

Operation Permit by: [signature] date 3/18/97

HEALTH DEPT. COPY: WHITE INSPECTION COPY (FINAL): GREEN OWNER COPY (FINAL): YELLOW INSPECTION COPY (INITIAL): PINK OWNER COPY (INITIAL): GOLD