IREDELL COUNTY HEALTH DEPARTMENT Const. Auth. STATESVILLE 704-878-5305 MOORESVILLE 704-664-5281

IMPROVEMENT PERMIT / ~~CERTIFICATE OF COMPLETION~~ / OPERATION PERMIT / EXISTING SYSTEM INSPECTION

PROPERTY DESCRIPTION NO. 23206 DATE Sept 3, '96 TAX MAP NO. part of 2SA80 Watershed: ☑ Yes ☐ No

OWNER OR CONTRACTOR James M. Harper ~~PHONE: Business~~ 4638-79-7126 Home

ADDRESS 1651 Lakefront Dr. Catawba

LOCATION Petty Rd. N. to Stumpy Creek Rd 2nd lot on left

SUBDIVISION Harborview BLOCK / SECTION II LOT 2 LOT AREA ~24,610+ft² SITE CLASS. Bpn. 1958 DESIGN FLOW 360 gpd L.T.A.R. ~.3

Septic Tank: 1000 Gallons; STB 55 Date 10/14/96

Pump Tank: _____ Gallons; PT _____ Date _____

Pump Make: _____ Model _____ Serial No. _____

Nitrification Field: No Fields 1 Square Feet 1200 Linear Feet 400

No Lines 4@100' Trench Width 36" Max Trench Bottom Depth ~24" Gravel Depth 12"

☑ New System ☐ Repair System Type: I, II, III, IV, V, VI,

System Description: gravity conventional

Repair System Description: gravity chamber/similar

Maintenance Agreement Required: ☐ Yes ☑ No

☑ House/Mod. Home No. Bedrooms 3

☐ Mobile Home No. Bathrooms 2

☐ Business No. Employees _____

☐ Other _____


☑ Slab ☑ Crawl Space ☐ Basement w/plumbing ☐ Basement wo/plumbing

Water Supply:
☐ Individual
☑ Community
☐ Public

Comments:

Comments: Installed as drawn. Step downs used in each trench line.

INITIAL SITE SKETCH 1"=50'

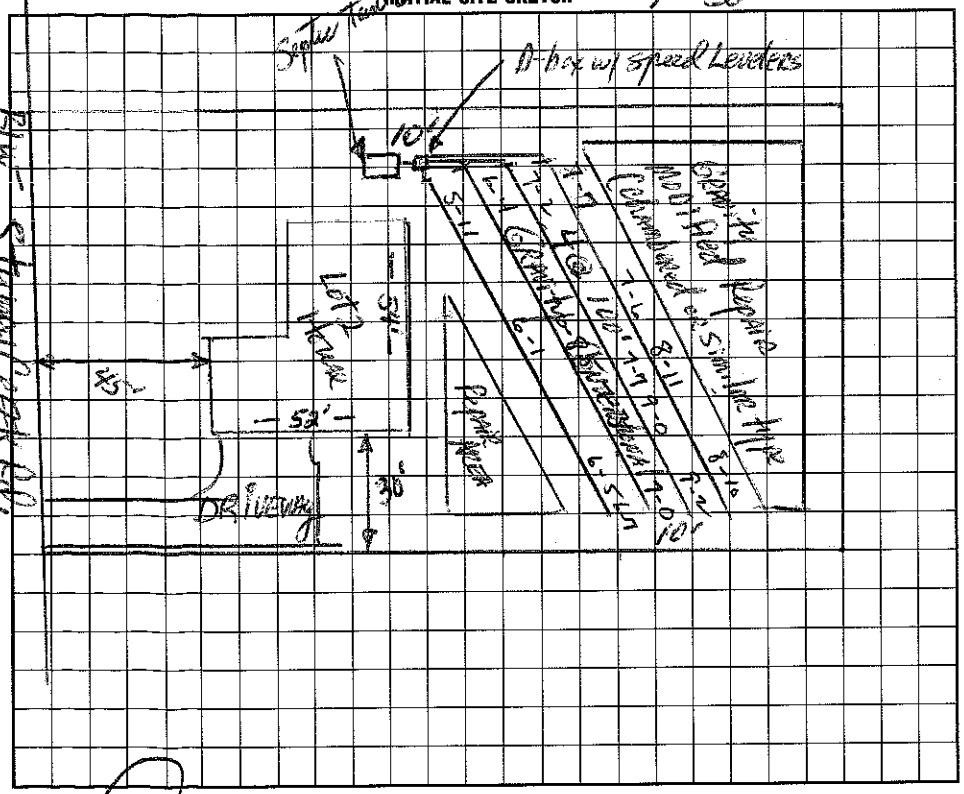

AS BUILT SKETCH

I understand that this permit can be suspended or revoked if any false information is supplied toward securing the permit/any unauthorized changes are made to the site/any unauthorized changes are made in the installation of the system.

Signed: James M. Harper

Improvement Permit by: _____ date 9-3-96

~~Existing System Inspection~~ Construction by: _____ date 9-3-96

Installed by: Kennedy Grading

Certificate of Completion by: _____ date _____

Operation Permit by: Wesley Sparks R.S. date 3/17/97

HEALTH DEPT. COPY: WHITE INSPECTION COPY (FINAL): GREEN OWNER COPY (FINAL): YELLOW INSPECTION COPY (INITIAL): PINK OWNER COPY (INITIAL): GOLD