(11:30) MADISON

IREDELL COUNTY HEALTH DEPARTMENT

STATESVILLE 704-878-5305 MOORESVILLE 704-664-5281

IMPROVEMENT PERMIT / AUTHORIZATION TO CONSTRUCT / OPERATION PERMIT / EXISTING SYSTEM INSPECTION

PERMIT# 23205 PIN# Part of 2 5 A 80 4638-99-8222 DATE 1/31/01

OWNER OR CONTRACTOR James Kemp PHONE: Business Home 662-6535

ADDRESS 394 Sundown Rd Mooresville NC 28117

LOCATION on corner of Stumpy Creek & Perth Rd

SUBDIVISION Harbor View BLOCK / SECTION II LOT 1 LOT AREA .6 AC SITE CLASS. PS DESIGN FLOW 360 L.T.A.R. 0.5

Septic Tank: 1000 Gallons; STB 794 Date 1/15/01
Pump Tank: ____ Gallons; PT ____ Date ____
Pump Make: ____ Model ____ Serial No. ____
Nitrification Field: No Fields 1 Square Feet 900 Linear Feet 300
No Lines 4 @ 75' Trench Width 36" Max Trench Bottom Depth ~~28~~ 25" Gravel Depth —

[X] New System [ ] Repair System Type: I, II, III, IV, V, VI
System Description: Gravity 25% Reduction
Repair System Description: Gravity/Pump 25% Red.
Maintenance Agreement Required: [ ] Yes [X] No

[X] House/Mod. Home [ ] Mobile Home [ ] Business [ ] Other
No. Bedrooms 3 No. Bathrooms 2.5 No. Employees ____


[ ] Slab [X] Crawl Space [ ] Basement w/plumbing [ ] Basement wo/plumbing

Water Supply: [ ] Individual [X] Public [X] Community

Comments:/Conditions:

Comments:/Conditions:

INITIAL SITE SKETCH

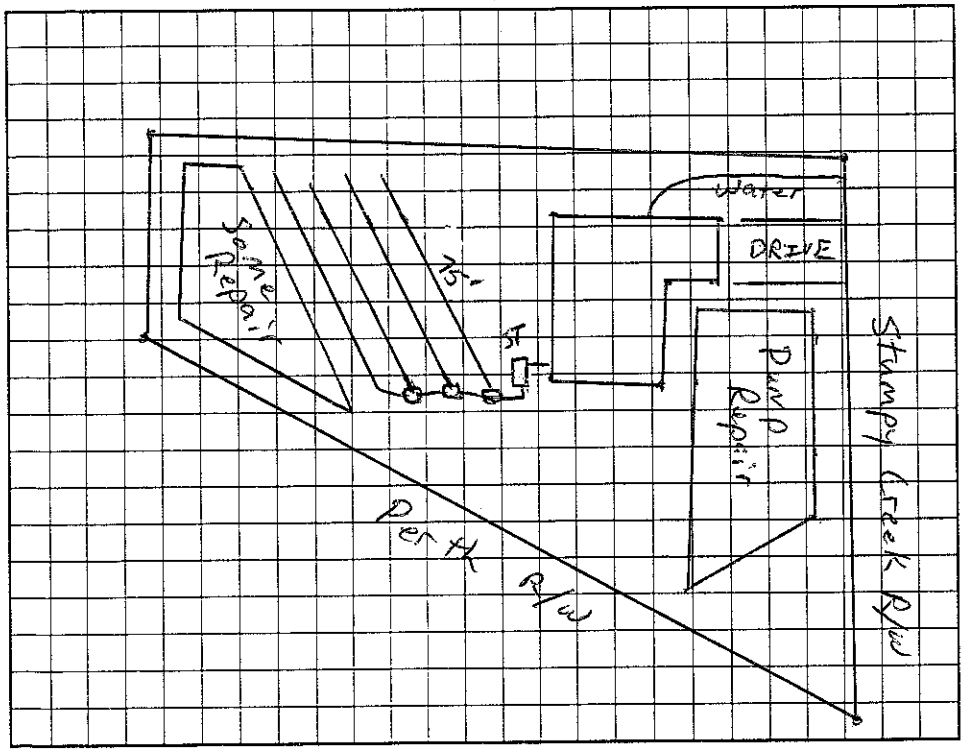

AS BUILT SKETCH

Permit can be suspended or revoked if any false information is supplied toward securing the permit/any unauthorized changes are made to the site/any unauthorized changes are made in the installation of the system. Improvement Permit with plat valid without expiration. Improvement Permit with site plan valid for sixty months. Authorization to Construct is valid for a period equal to that of Improvement Permit – not to exceed sixty months.

Signed: James Kemp date ____ Installed by: C & M

Improvement Permit by: [signature] date 1/31/01 Operation Permit by: [signature] RSI date 3/9/01

Authorization to Construct by: [signature] date 1/31/01 Existing System Inspection by: ____ date ____

HEALTH DEPT. COPY: WHITE OWNER COPY (FINAL): YELLOW OWNER COPY (INITIAL): PINK