# IREDELL COUNTY HEALTH DEPARTMENT

STATESVILLE 704-878-5305 MOORESVILLE 704-664-5281

## IMPROVEMENT PERMIT / AUTHORIZATION TO CONSTRUCT / OPERATION PERMIT / EXISTING SYSTEM INSPECTION

PERMIT# 149915 PIN# 4638831890 DATE 4-30-08

OWNER OR APPLICANT Girdharry Lall PHONE: Business 704-258-3794 Home

ADDRESS 1183 Robinhood Cir. Charlotte NC 28227

LOCATION 150 W. TR Perth, 2nd lot past W. Wilson Lake Rd

SUBDIVISION — BLOCK / SECTION — LOT — LOT AREA 3.39 Ac SITE CLASS. DESIGN FLOW 480 L.T.A.R. .5

Septic Tank: Gallons: STB Date

Pump Tank: Gallons: PT Date

Pump Make: Model Serial No.

Nitrification Field: No Fields Square Feet Linear Feet

No Lines Trench Width Max Trench Bottom Depth Gravel Depth ☐ Gravity ☒ Pressure

☐ New System ☐ Repair ☐ Expansion System Type: I II III IV V VI

System Description: Pm / Convention

Repair System Description:

Maintenance Agreement Required: ☐ Yes ☒ No

☒ House/Mod. Home No. Bedrooms 4

☐ Mobile Home No. Persons

☐ Business No. Employees

☐ Other


Water Supply: ☒ Individual ☐ Public ☐ Community

☐ Slab ☐ Crawl Space ☐ Basement w/plumbing ☒ Basement wo/plumbing


Comments:/Conditions:

Comments:/Conditions: System good for up to 6 bedrooms
Do not build new house closer than 10' to Septic Tank

INITIAL SITE SKETCH

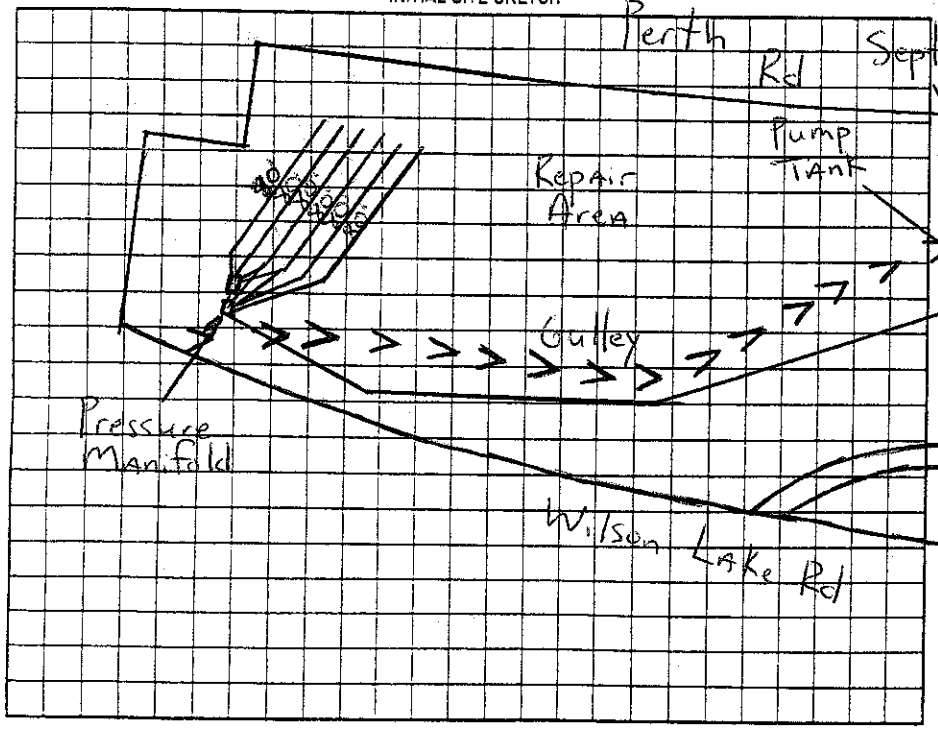


AS BUILT SKETCH

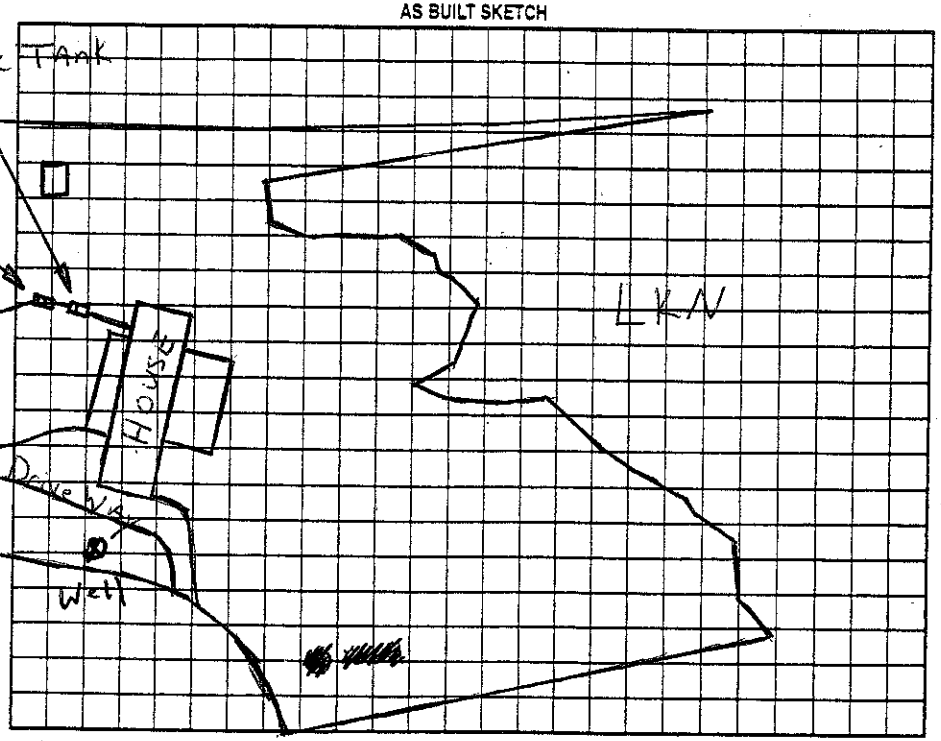


Permit can be suspended or revoked if any false information is supplied toward securing the permit/any unauthorized changes are made to the site/any unauthorized changes are made in the installation of the system. Improvement Permit with plat valid without expiration ☐ Improvement Permit with site plan valid for sixty months ☐ Authorization to Construct is valid for a period equal to that of Improvement Permit – not to exceed sixty months.

Signed: date 5/2/08

Improvement Permit by: date

Authorization to Construct by: date

Installed by:

Operation Permit by: date

Existing System Inspection by: date 4-30-08

HEALTH DEPT. COPY: WHITE OWNER COPY (FINAL): YELLOW OWNER COPY (INITIAL): PINK