1:00

IREDELL COUNTY HEALTH DEPARTMENT

STATESVILLE 704-878-5305 MOORESVILLE 704-664-5281

IMPROVEMENT PERMIT / CERTIFICATE OF COMPLETION / OPERATION PERMIT / EXISTING SYSTEM INSPECTION

PROPERTY DESCRIPTION NO. 22983 DATE 10/31/96 TAX MAP NO. pt of 2PB14 Watershed: ☐ Yes ☐ No

OWNER OR CONTRACTOR SHIRLEY RICO PHONE: Business 344-6103 Home 364-1755

ADDRESS 1509 RONNYMEDE LN CHARLOTTE, NC 28211

LOCATION 150 W-JR PERTHRO. JR NELSON LAKE RD.

SUBDIVISION CRESLEN/LN BLOCK / SECTION 11 LOT 1085 LOT AREA .884AC SITE CLASS. BS DESIGN FLOW 360GPD L.T.A.R. .36FPD/FT

Septic Tank: 1000 Gallons; STB 825 Date 8/21/97

Pump Tank: _____ Gallons; PT _____ Date _____

Pump Make: _____ Model _____ Serial No. _____

Nitrification Field: No Fields 1 Square Feet 900 Linear Feet 300

No Lines 4 Trench Width 36" Max Trench Bottom Depth 36" Gravel Depth N/A

☑ New System ☐ Repair System Type: I, II, (III) IV, V, VI

System Description: GRAVITY CHAMBERED OR STONE

Repair System Description: MODIFIED – Pump?

Maintenance Agreement Required: ☐ Yes ☑ No

☑ House/Mod. Home No. Bedrooms 3

☐ Mobile Home No. Bathrooms 3

☐ Business No. Employees _____

☐ Other _____


☐ Slab ☑ Crawl Space ☐ Basement w/plumbing ☐ Basement wo/plumbing

Water Supply: ☑ Individual ☐ Community ☐ Public


Comments:

Comments: Installed as drawn

INITIAL SITE SKETCH 1"=50'

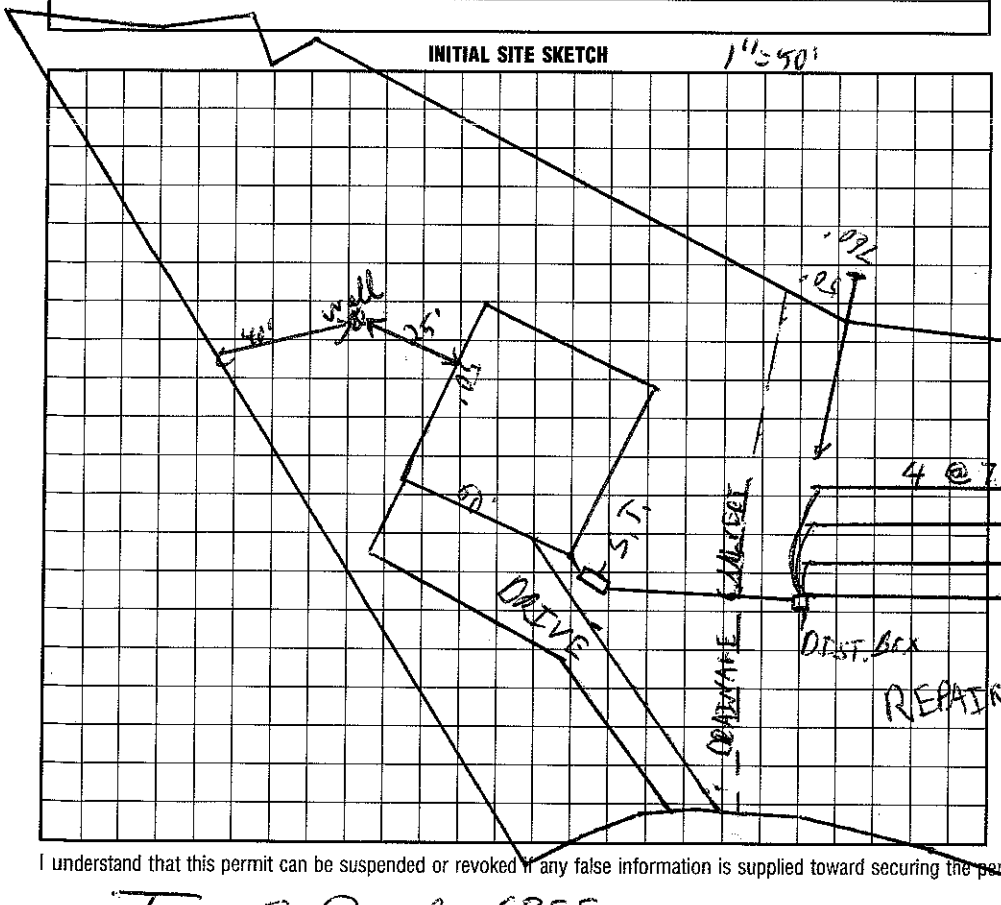

AS BUILT SKETCH

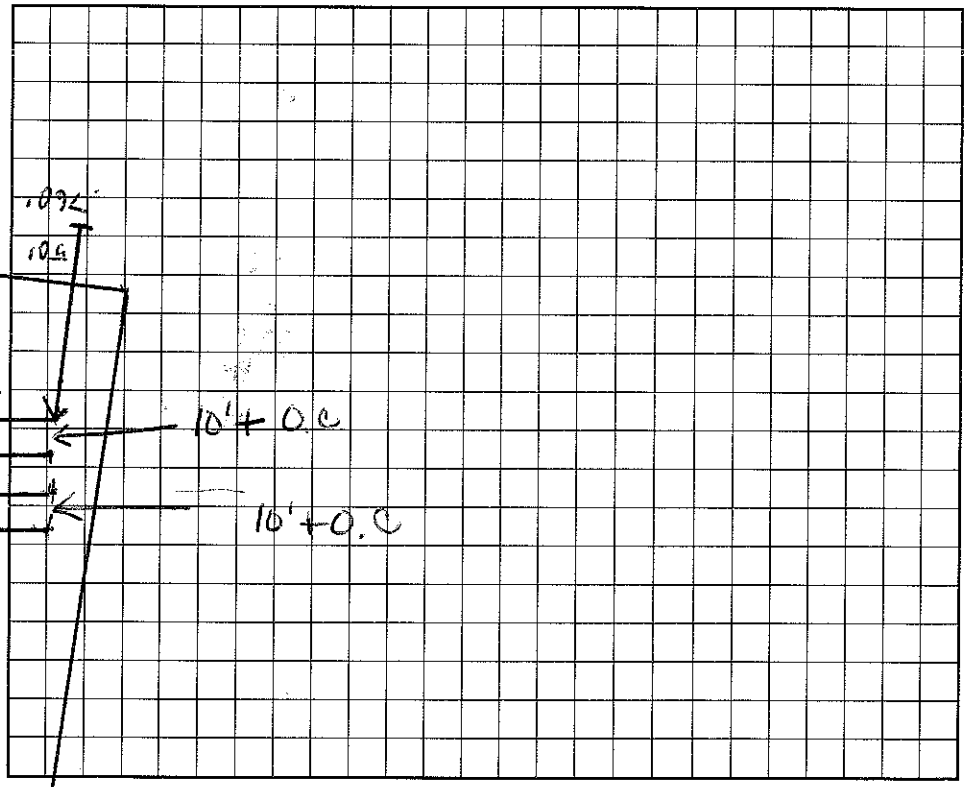

I understand that this permit can be suspended or revoked if any false information is supplied toward securing the permit/any unauthorized changes are made to the site/any unauthorized changes are made in the installation of the system.

Signed: Tony C Jacob, CPSS (P)

Improvement Permit by: C. Ray Thomas EHSF date 10/31/96

AUTHORIZATION TO CONSTRUCT

~~Existing System Inspection by:~~ C. Ray Thomas EHSF date 10/31/96

Installed by: Bostic

Certificate of Completion by: Maina H. Dotson date 10/15/97

Operation Permit by: Maina H. Dotson date 10/15/97

HEALTH DEPT. COPY: WHITE INSPECTION COPY (FINAL): GREEN OWNER COPY (FINAL): YELLOW INSPECTION COPY (INITIAL): PINK OWNER COPY (INITIAL): GOLD