IREDELL COUNTY HEATLH DEPARTMENT

PAGE 2: *SITE PLAN WORKSHEET*

SEE THE SAMPLE SITE PLAN BELOW. INCOMPLETE SITE PLANS WILL BE RETURNED TO YOU FOR COMPLETION AND MAY RESULT IN A DELAY IN THE ISSUANCE OF YOUR SEPTIC SYSTEM PERMIT!!!

Place an (X) beside each item as you complete the site plan:

- x — Property Line measurements are clearly identified…
- x — All proposed structures are indicated…
  SHOW: proposed house or business footprint, wells, water lines, patios, pools and decks, and any other item that will occupy space on the site
- x — Front and side setbacks from property line…
- x — ~~Preferred~~ driveway location and configuration, ~~preferred~~ well location…
- x — Area ~~you prefer~~ your septic system ~~to be~~ placed…
- x — North arrow, or other sufficient indicator of direction…


Circle N/A on the following if appropriate:

- N/A — Location of septic systems and wells within 100' of your property… N/A
- N/A — Location of easements and rights of ways on your property… N/A
- N/A — Location of any designated wetlands on the property… N/A


Signature: Shirley A. Reid
Property owner or owner's legal representative signature (SIGNATURE REQUIRED)

02-15-05
DATE

USE THIS SPACE TO DRAW YOUR SITE PLAN

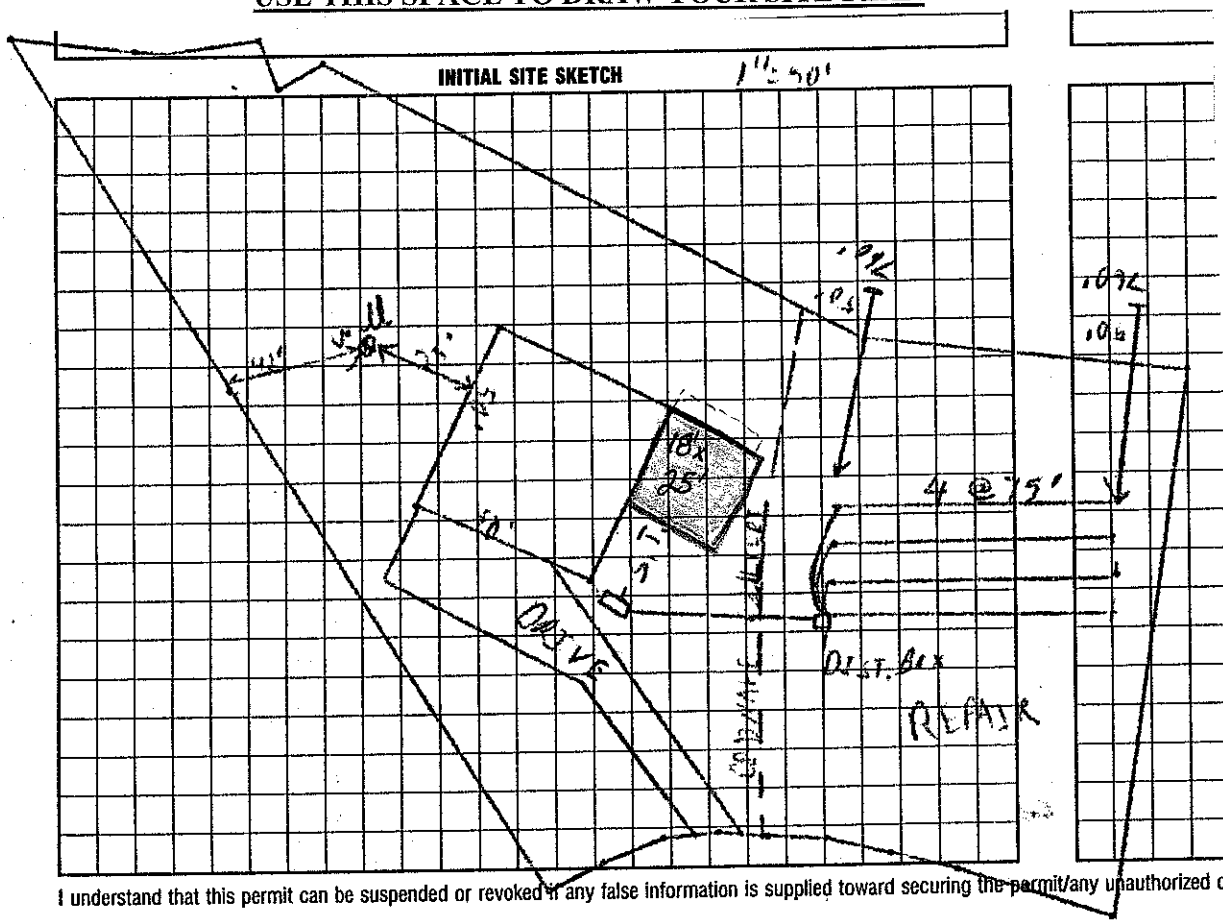

The 18' x 25' ADDITION (MARKED IN RED) will HAVE ONE (1) BATHROOM. A 3-BEDROOM, 3-BATH SEPTIC SYSTEM WAS APPROVED AND INSTALLED 1997. A 2-BEDROOM, 2 BATH HOUSE IS PRESENTLY ON SITE.

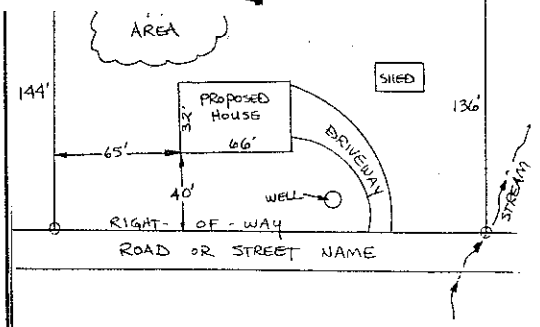

LAKE NORMAN
DUKE
AREA = 0.076 ACRE
DRIVE
WELL
WILSON LAKE