IREDELL COUNTY HEALTH DEPARTMENT

Authorization to Construct

STATESVILLE 704-878-5305 — MOORESVILLE 704-664-5281 — 4638 836744

IMPROVEMENT PERMIT / ~~CERTIFICATE OF COMPLETION~~ / OPERATION PERMIT / EXISTING SYSTEM INSPECTION

PROPERTY DESCRIPTION NO. 23344 DATE 6/2/96 – Mistake 7/2/96 TAX MAP NO. 2P-5-4-32 Watershed: ☒ ~~Yes~~ ☐ No

OWNER OR CONTRACTOR Steve Turner PHONE: Business _____ Home 998-4622

ADDRESS 208 Howard Town Rd. Mocksville NC 27028

LOCATION Perth Rd. TR Wilson Rd - on Rd before 171 Wilson Lake Rd

SUBDIVISION C L T BLOCK / SECTION 11 LOT 32 ~~Acres~~ LOT AREA .876 ac SITE CLASS. RS DESIGN FLOW 360 ~~gpd~~ T.A.R. ≈ .3 gpd

Septic Tank: 1000 Gallons; STB 794 Date 5/6/96
Pump Tank: _____ Gallons; PT _____ Date _____
Pump Make: _____ Model _____ Serial No. _____
Nitrification Field: No Fields 1 Square Feet ~~720~~ 720 Linear Feet 240
No Lines 6 Trench Width 20 Max Trench Bottom Depth 36" Gravel Depth N/A

☑ New System ☐ Repair System Type: I, II, III, IV, V, VI
System Description: Gravity Pond
Repair System Description: (Developed before 83)
Maintenance Agreement Required: ☐ Yes ☐ No


☑ House/Mod. Home No. Bedrooms 3
☐ Mobile Home No. Bathrooms 2
☐ Business No. Employees _____
☐ Other _____
☐ Slab ☐ Crawl Space ☐ Basement w/plumbing ☐ Basement wo/plumbing

Water Supply:
☑ Individual
☐ Community
☐ Public

Comments: Trailer May be set up if 18" per foot may be obtained w/out line being deep.
- C. Ruby Town

Comments:

INITIAL SITE SKETCH

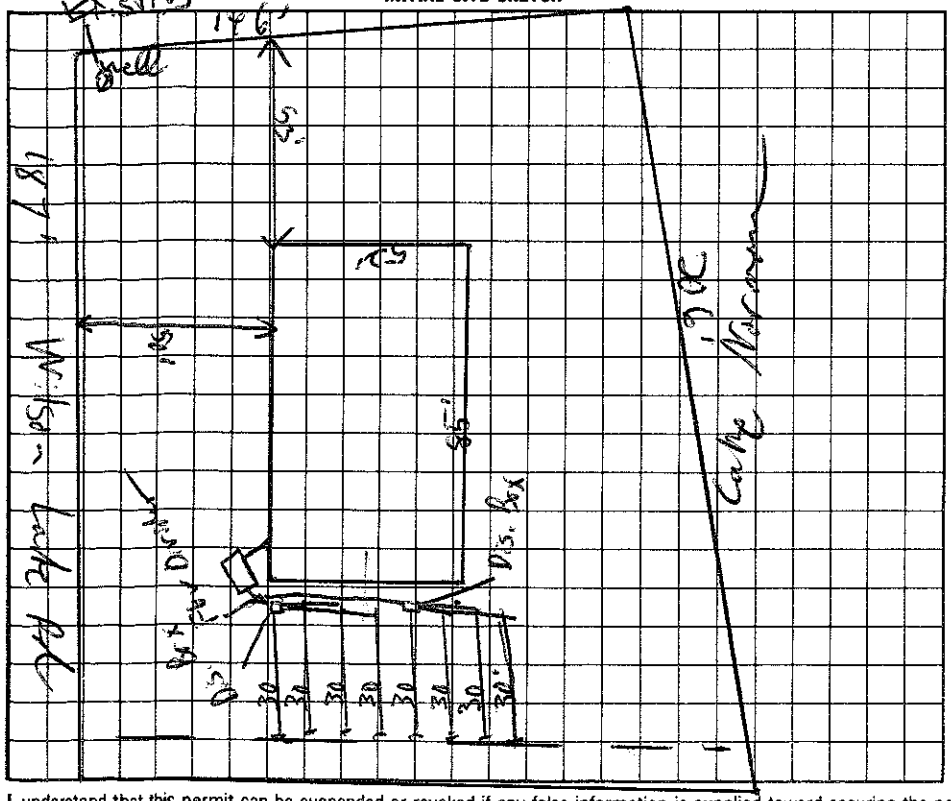

AS BUILT SKETCH

Same as site sketch

I understand that this permit can be suspended or revoked if any false information is supplied toward securing the permit/any unauthorized changes are made to the site/any unauthorized changes are made in the installation of the system.

Signed: Steve Turner

Improvement Permit by: C. Ruby Town EHST date 6/2/96

Existing System Inspection by: C. Ruby Town EHST date 6/2/96

Mistake – 7/2/96 – C. Ruby Town

Installed by: LARRY McDANIEL

Certificate of Completion by: _____ date _____

Operation Permit by: C. Ruby Town EHST date 7/30/96

HEALTH DEPT. COPY: WHITE — INSPECTION COPY (FINAL): GREEN — OWNER COPY (FINAL): YELLOW — INSPECTION COPY (INITIAL): PINK — OWNER COPY (INITIAL): GOLD