IREDELL COUNTY HEALTH DEPARTMENT

STATESVILLE 704-878-5305 MOORESVILLE 704-664-5281

IMPROVEMENT PERMIT / AUTHORIZATION TO CONSTRUCT / OPERATION PERMIT / EXISTING SYSTEM INSPECTION

$25.00 ta'd

PERMIT# 127507 PIN# 4638 83 8407 DATE 5/26/05

OWNER OR CONTRACTOR Clay Stimpson Bldrs PHONE: Business 336-945-2226 Home

ADDRESS 320 Scott Rd Lewisville NC 27023

LOCATION 150 W, TR Perth, TR Lakeshore Sch, TL Wilson LK, on LT

SUBDIVISION CL+T BLOCK / SECTION 11 LOT 30 LOT AREA 0.67 AC SITE CLASS PS DESIGN FLOW 480 L.T.A.R. 0.3

Septic Tank: 1000 Gallons; STB 714 Date 11/29/05

Pump Tank: 1000 Gallons; PT 27 Date 12/14/05

Pump Make: Bowles Model WED 311M Serial No. 10/05

Nitrification Field: No Fields 1 Square Feet 810 Linear Feet 270

No Lines 5@54' Trench Width 24" Max Trench Bottom Depth 36" Gravel Depth —

☒ New System ☐ Repair System Type: I, II, III, (IV), V, VI

System Description: LP Panel Block

Repair System Description: Limited .1945(c)

Maintenance Agreement Required: ☒ Yes ☐ No

☒ House/Mod. Home No. Bedrooms 4

☐ Mobile Home No. Bathrooms

☐ Business No. Employees

☐ Other

☐ Slab ☒ Crawl Space ☐ Basement w/plumbing ☐ Basement wo/plumbing


Water Supply: ☒ Individual ☐ Public ☐ Community

Comments:/Conditions: 1"=40'


Comments:/Conditions: 5" to PVC

623 Panel @ 86.5 TOP.

INITIAL SITE SKETCH

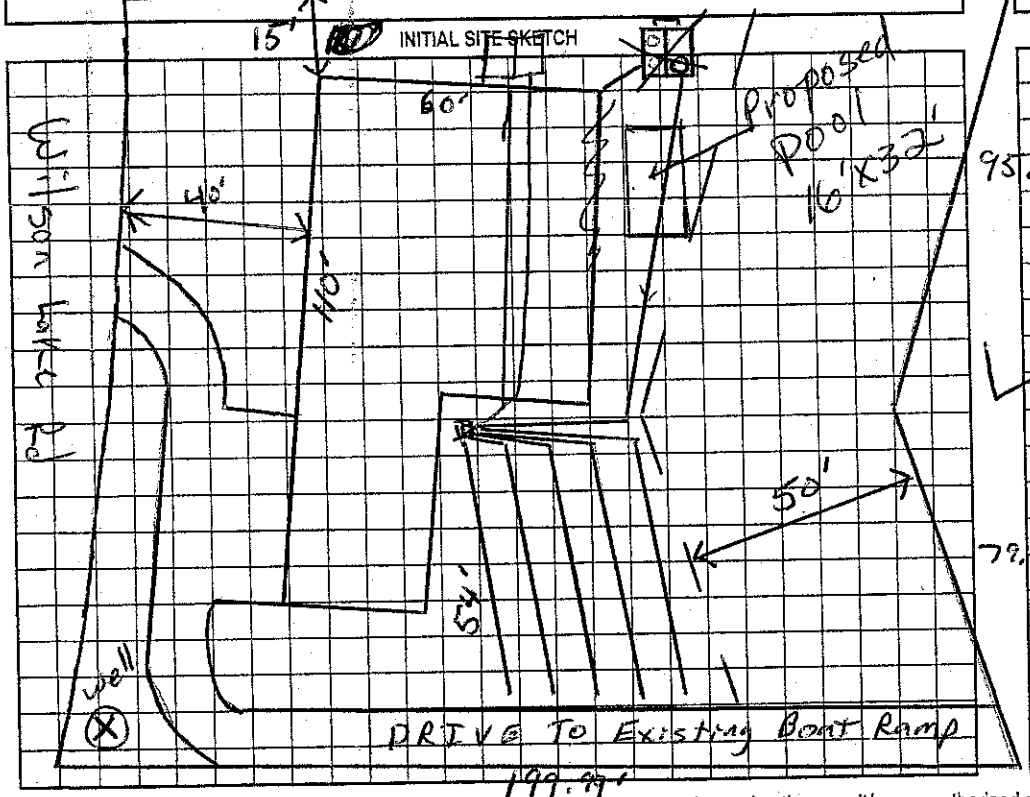

AS BUILT SKETCH

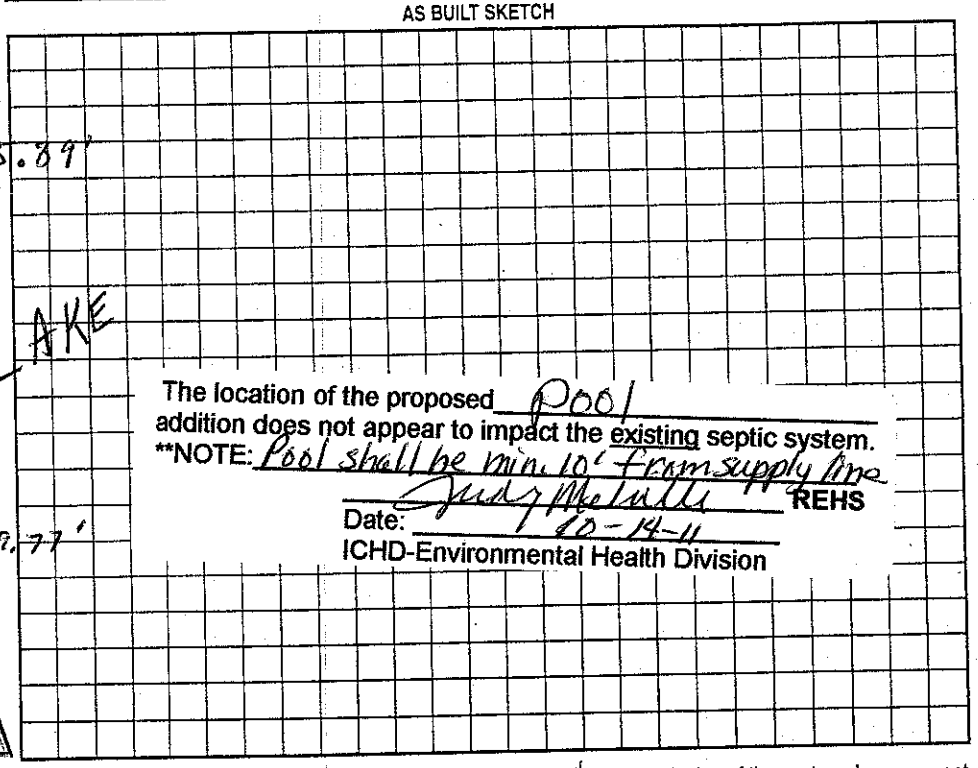

The location of the proposed Pool addition does not appear to impact the existing septic system.

**NOTE: Pool shall be min. 10' from supply line

Judy McLittle REHS

Date: 10-14-11

ICHD-Environmental Health Division

Permit can be suspended or revoked if any false information is supplied toward securing the permit/any unauthorized changes are made to the site/any unauthorized changes are made in the installation of the system. Improvement Permit with plat valid without expiration. Improvement Permit with site plan valid for sixty months. Authorization to Construct is valid for a period equal to that of Improvement Permit – not to exceed sixty months.

Signed: Clay Stimpson date 6-2-05 Installed by: Marty Tucker

Improvement Permit by: RS date 5/26/05 Operation Permit by: Wesley Sparks RS date 5/16/06

Authorization to Construct by: RS date 5/26/05 Existing System Inspection by: date

HEALTH DEPT. COPY: WHITE OWNER COPY (FINAL): YELLOW OWNER COPY (INITIAL): PINK