IREDELL COUNTY HEALTH DEPARTMENT

STATESVILLE 704-878-5305 525.00 Paid MOORESVILLE 704-664-5281

IMPROVEMENT PERMIT / AUTHORIZATION TO CONSTRUCT / OPERATION PERMIT / EXISTING SYSTEM INSPECTION

PERMIT# 127507 PIN# 4638 83 8407 DATE 5/26/05

OWNER OR CONTRACTOR Clay Stimpson Bldrs PHONE: Business 336-945-2228 Home

ADDRESS 320 Scott Rd Lewisville NC 27023

LOCATION 150 W, TR Perth, TR Lakeshore Sch, TL Wilson LK, on Lt

SUBDIVISION CL+T BLOCK / SECTION 11 LOT 30 LOT AREA 0.67 Ac SITE CLASS PS DESIGN FLOW 480 L.T.A.R. 0.3

Septic Tank: 1000 Gallons; STB 744 Date 11/29/05
Pump Tank: 1000 Gallons; PT 27 Date 12/16/05
Pump Make: Gaulos Model WED 311M Serial No. 10/05
Nitrification Field: No Fields 1 Square Feet 810 Linear Feet 270
No Lines 5@54' Trench Width 24" Max Trench Bottom Depth 36" Gravel Depth —

☒ New System ☐ Repair System Type: I, II, III, (IV), V, VI
System Description: LP Panel Block
Repair System Description: Limited .1945(c)
Maintenance Agreement Required: ☒ Yes ☐ No

☒ House/Mod. Home No. Bedrooms 4
☐ Mobile Home No. Bathrooms
☐ Business No. Employees
☐ Other


Water Supply: ☒ Individual ☐ Public ☐ Community

☐ Slab ☒ Crawl Space ☐ Basement w/plumbing ☐ Basement wo/plumbing


Comments:/Conditions: 1"=40'

Comments:/Conditions: 5" Fall in 623 Panel 0365 Cap.

INITIAL SITE SKETCH

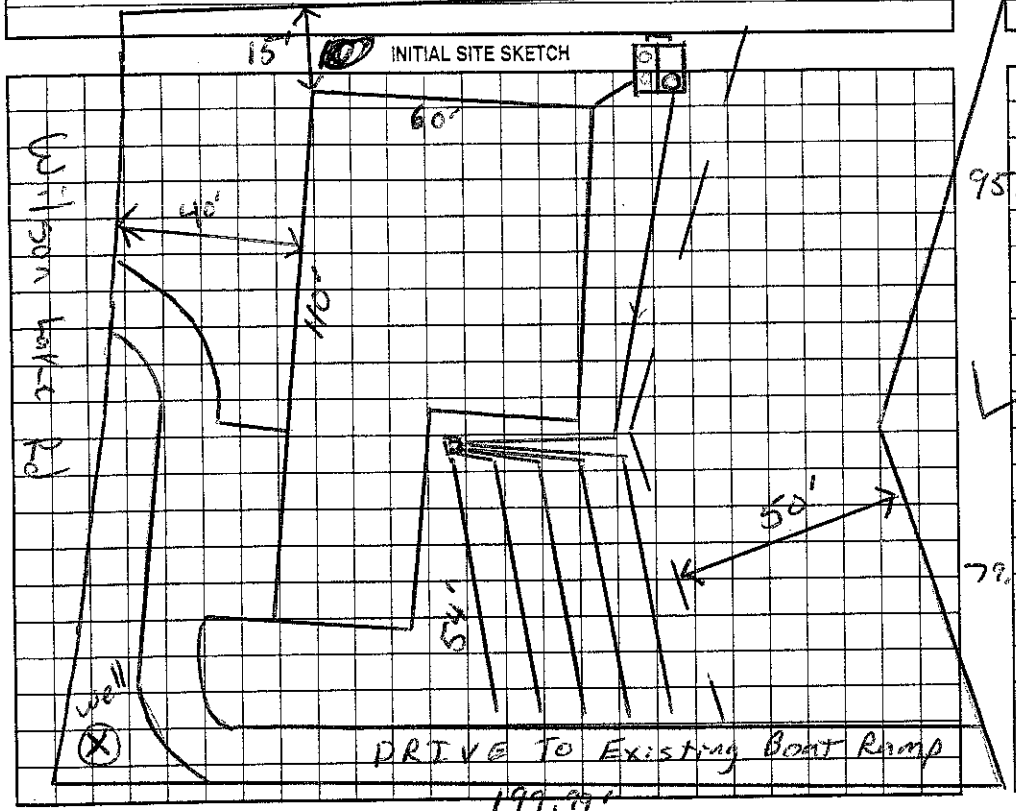

AS BUILT SKETCH

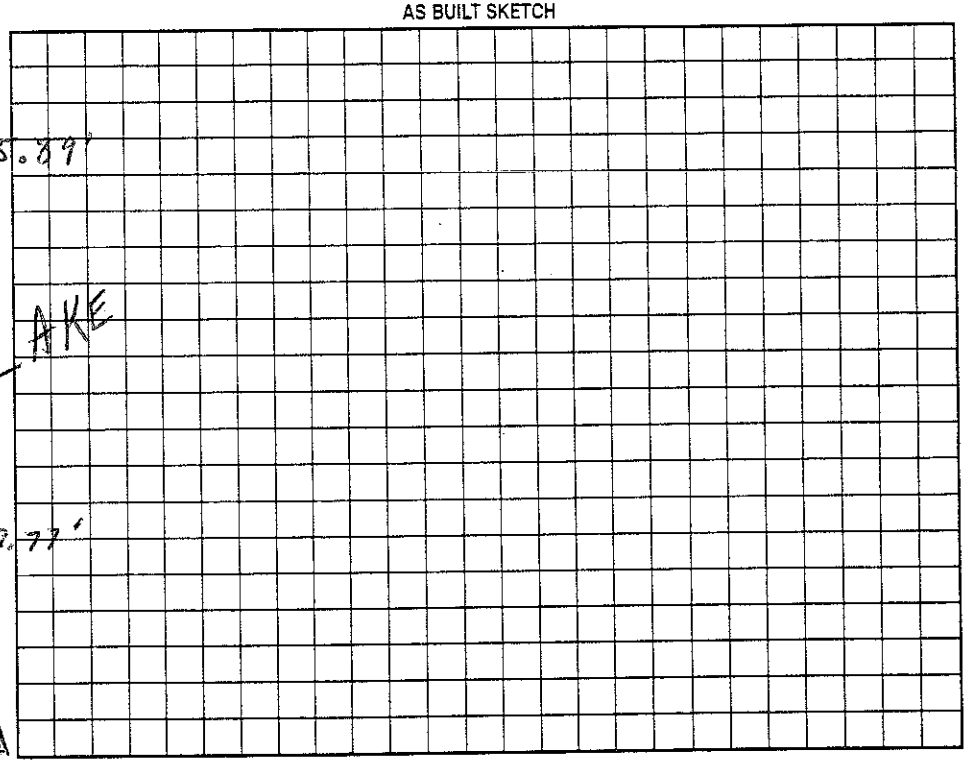

Permit can be suspended or revoked if any false information is supplied toward securing the permit/any unauthorized changes are made to the site/any unauthorized changes are made in the installation of the system. Improvement Permit with plat valid without expiration. Improvement Permit with site plan valid for sixty months. Authorization to Construct is valid for a period equal to that of Improvement Permit – not to exceed sixty months.

Signed: Clay Stimpson date 6-2-05 Installed by: Marty Tucker

Improvement Permit by: RS date 5/24/05 Operation Permit by: Wesley Hendrix RS date 5/16/06

Authorization to Construct by: RS date 5/26/05 Existing System Inspection by: date

HEALTH DEPT. COPY: WHITE OWNER COPY (FINAL): YELLOW OWNER COPY (INITIAL): PINK