r 27 Sec 11

IREDELL COUNTY HEALTH DEPARTMENT

Statesville Phone TR 3-7271 Mooresville Phone NO 3-1271

PERMIT TO INSTALL SEPTIC TANK

Permit No. 96 Permit Date 6 - 1 - 1972

Owner Author Wilson Address Mooresville

Installed By Julian Bowles Address Mooresville


Location of Property Perth Rd to Road to right before bridge go apprx 3mi on right

Tank		Capacity		Length of Lines		Fixtures	
Block	( )	1000	(✓)	225'	(✓)	No. of Baths	(2)
Precast	(✓)	1250	( )	250'	( )	Dishwasher	(No)
		1500	( )	Other		Garbage Grdr.	(No)
		Other				Other	

NOTIFY HEALTH DEPARTMENT AT LEAST EIGHT HOURS BEFORE TANK IS TO BE INSPECTED.

Final Inspection 6 - 1 - 1972 Approved (✓) Disapproved ( )

Remarks

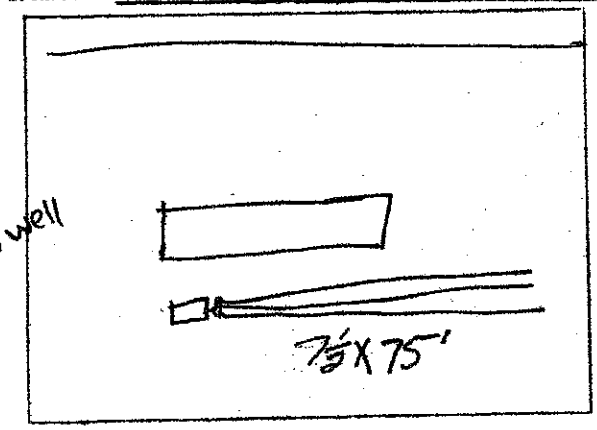

Sketch of Installation

J. C. Moore
Sanitarian