IREDELL COUNTY HEALTH DEPARTMENT

Statesville Office (704) 878-5305 / Mooresville Office (704) 660-3625 — DSE

PERMIT # 209808

IMPROVEMENT PERMIT / AUTHORIZATION TO CONSTRUCT / OPERATION PERMIT / EXISTING SYSTEM

PIN # 4638-83-9062

APPLICANT: Robert Lawing

APPLICANT ADDRESS: PO Box 468 Denver NC 28037

SITE ADDRESS: 211 Wilson Lake Rd

PHONE: 704-201-2316 ALT. PHONE:

SITE DIRECTIONS: Perth, TR Lakeshore, TL Wilson Lake Rd, on L

SUBDIVISION: Clet

SECTION: 11 LOT # 27 LOT AREA: DESIGN FLOW: 360 L.T.A.R.:

Septic Tank Ex. 1000 (gal) STB Date

Pump Tank (gal) PT Date

Pump Make Model Serial #

Nitrification Fields # Lines Linear Ft:

Trench Width Max. Trench Bottom Depth Gravel Depth

☐ New System ☐ Repair ☐ Expansion System Type: I ☒ II III IV V VI

System Description: Gravel Bed

Repair System Description:

Maintenance Agreement Required: ☐ YES ☒ NO

☒ GRAVITY ☐ PRESSURE

☒ Residence ☐ Business ☐ Other ☐ Slab ☐ Basement w/plumbing

No. Bedrooms 3 No. Persons No. Employees

☒ Crawl Space ☐ Basement w/o plumbing

Water Supply: ☒ Private ☐ Public ☐ Community

Comments / Conditions: System appears to be working @ time of inspection


INITIAL SITE SKETCH

Owner/Applicant Lawing

EHS RA

Amount Owed $ 0

AS BUILT SKETCH

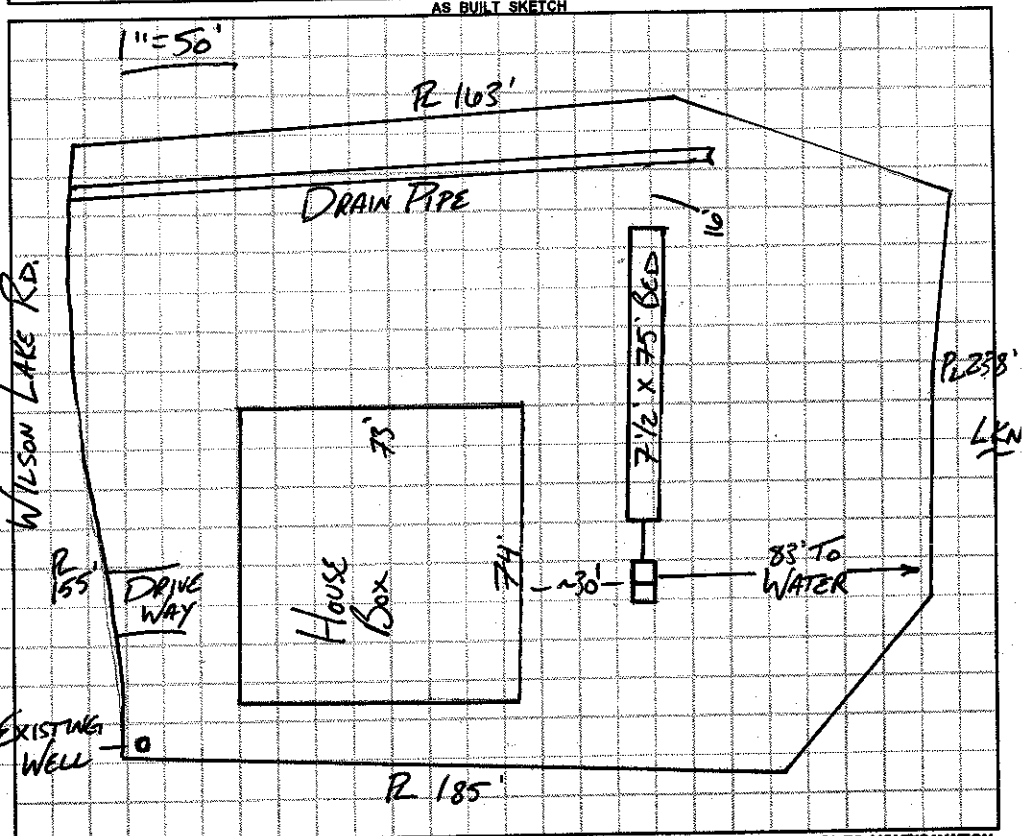

Permit can be suspended or revoked if any false information is supplied toward securing the permit / any unauthorized changes are made to the site / any unauthorized changes are made in the installation of the system. **CONTACT A LOCATOR SERVICE PRIOR TO ANY EXCAVATION**

☐ **IMPROVEMENT PERMIT** *with plat valid without expiration.* ☐ **IMPROVEMENT PERMIT** *with site plan valid for 60 mos.* ☐ **AUTHORIZATION TO CONSTRUCT** *valid for period equal to IMPROVEMENT PERMIT--not to exceed 60 mo.*

Owner / Applicant Signature: Robert T. Rawing Date: 5/26/15

IMPROVEMENT PERMIT by: Date:

AUTHORIZATION TO CONSTRUCT by: Date:

Installed by:

OPERATION PERMIT by: Date:

Existing System Inspected by: RA Date: 5-14-15

Health Dept. Copy - WHITE Applicant (Final Approval) - YELLOW Applicant (Conditional Approval) - PINK