...CDELL COUNTY HEALTH DEPARTMENT

STATESVILLE 704-878-5305 MOORESVILLE 704-664-5281

IMPROVEMENT PERMIT / CERTIFICATE OF COMPLETION / OPERATION PERMIT / EXISTING SYSTEM INSPECTION

Authorization to Construct Grand Bay Amenity Area

PROPERTY DESCRIPTION NO. 22126 DATE 6/12/97 TAX MAP NO. Pt of 2 A 14

OWNER OR CONTRACTOR Grand Bay Development Co. PHONE: Business 663-5115 Home 463884 0231

ADDRESS 166 Catawbain Rd. Mooresville, NC. 28115 Watershed: ☒ Yes ☐ No

LOCATION Nor. on Grand Bay Drive, to cul-de-sac (R) up drive

SUBDIVISION GRAND BAY BLOCK / SECTION N/A-2 LOT 80 N/A LOT AREA ~ 3AC SITE CLASS PS DESIGN FLOW 800 L.T.A.R. .35

Septic Tank: 1500 Gallons; STB 797 Date 5/23/97

Pump Tank: 1500 Gallons; PT 797 Date 5/4/97

Pump Make: _____ Model _____ Serial No. _____

Nitrification Field: No Fields 1 Square Feet 1710 Linear Feet 570

No Lines 5 Trench Width 36" Max Trench Bottom Depth 66" Gravel Depth 24" SAND

☒ New System ☐ Repair System Type: I, II, (III), IV, V, VI

System Description: PRESMAN → CH PLASTIC

Repair System Description: SAME - FORMER DRAINFIELD

Maintenance Agreement Required: ☒ Yes ☐ No

☐ Slab ☒ Crawl Space ☐ Basement w/plumbing ☐ Basement wo/plumbing

☐ House/Mod. Home No. Bedrooms ____

☐ Mobile Home No. Bathrooms ____

☐ Business No. Employees ____


☒ Other 80 @ 10 GAL/PERSON

Water Supply: ☒ Individual ☐ Community ☐ Public


Comments:
DO NOT BEGIN WORK WITHOUT CONSULTANTS SIDEVIEW OF TRENCH CONSTRUCTION

Comments: * FIELD AREA
~ 80 PERSON POOL - CLUBHOUSE BUILDING
35 - 38 GPM 13' Drawdown

INITIAL SITE SKETCH

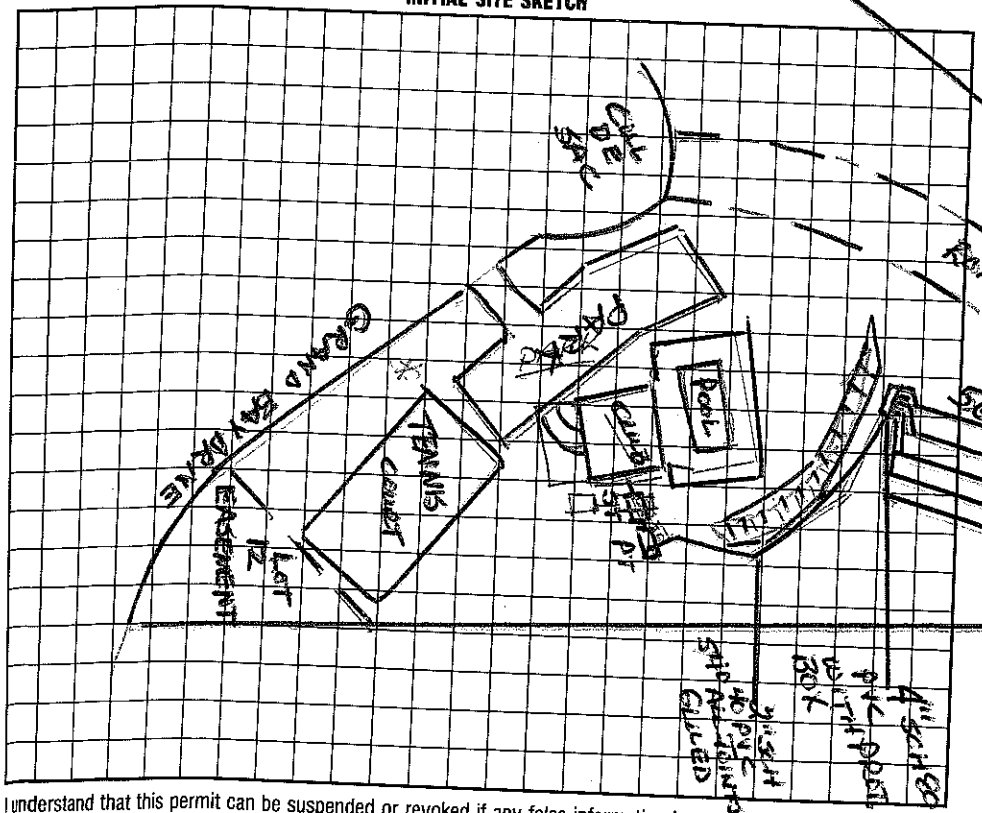

AS BUILT SKETCH

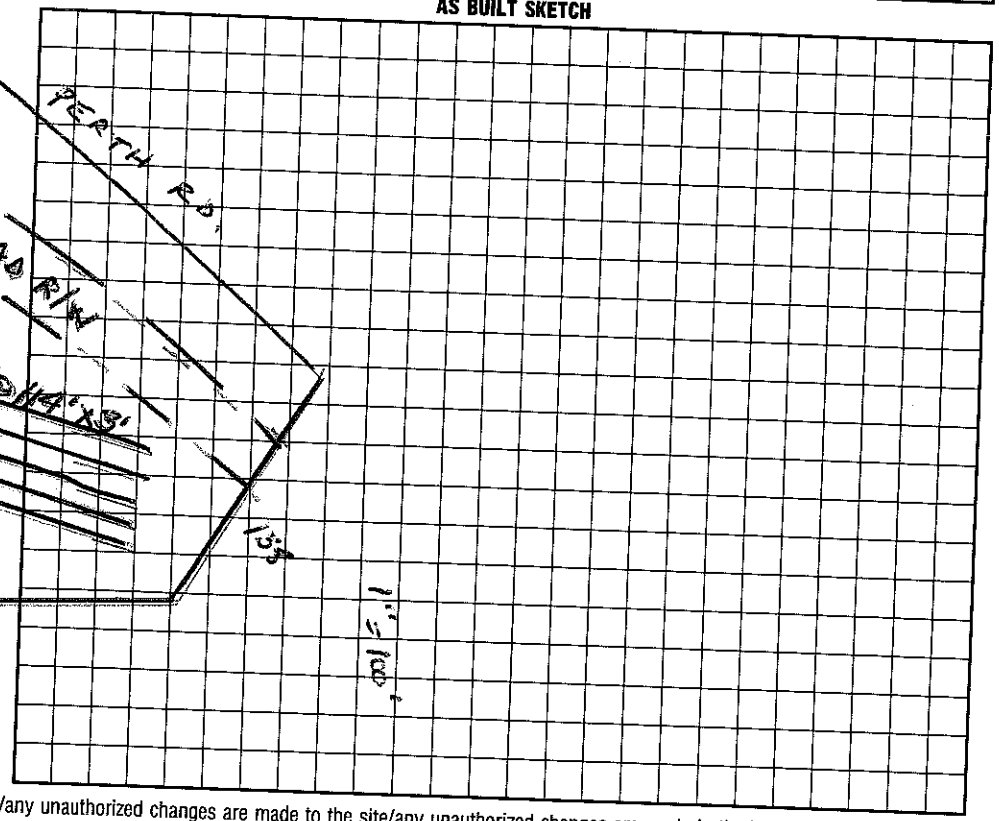

I understand that this permit can be suspended or revoked if any false information is supplied toward securing the permit/any unauthorized changes are made to the site/any unauthorized changes are made in the installation of the system. Improvement Permit is valid for 60 months from date of issuance.

Signed: * Tim Whitaker AGENT for T.W.P.

Improvement Permit by: Wesley Sparks R.S. date 6/13/97

Existing System Inspection by: Wesley Sparks R.S. date 6/13/97

Installed by: Willie Christenbury

Certificate of Completion by: Wesley Sparks R.S. date 7/16/97

Operation Permit by: Wesley Sparks R.S. date 7/16/97

HEALTH DEPT. COPY: WHITE INSPECTION COPY (FINAL): GREEN OWNER COPY (FINAL): YELLOW INSPECTION COPY (INITIAL): PINK OWNER COPY (INITIAL): GOLD