IREDELL COUNTY HEALTH DEPARTMENT

→ AUTHORIZATION TO CONSTRUCT (3,30)

STATESVILLE 704-878-5305 MOORESVILLE 704-664-5281

IMPROVEMENT PERMIT / ~~CERTIFICATE OF COMPLETION~~ / OPERATION PERMIT / EXISTING SYSTEM INSPECTION

PROPERTY DESCRIPTION NO. 23226 DATE 8/12/96 TAX MAP NO. pt of 25A80 Watershed: ☐ Yes ☐ No

OWNER OR CONTRACTOR STUMPY CREEK LLC PHONE: Business 633-6124 ~~Home~~ 4638-86-0384

ADDRESS 614 N MAIN ST. SALISBURY NC 28144

LOCATION 150W - TR PERTH RD. - TL HIDEAWAY LN. 5TH LOT ON RT.

SUBDIVISION HARBORVIEW BLOCK / SECTION 1 LOT 5 LOT AREA .61 Ac SITE CLASS. PS DESIGN FLOW ~~480~~GPD L.T.A.R. 360/FT =

Septic Tank: 1000 Gallons; STB 825 Date 12/27/96

Pump Tank: _____ Gallons; PT _____ Date _____

Pump Make: _____ Model _____ Serial No. _____

Nitrification Field: No Fields 1 Square Feet 1200 Linear Feet 400

No Lines 5 Trench Width 36" Max Trench Bottom Depth 22" Gravel Depth N/A

☑ New System ☐ Repair System Type: I. II. (III) IV. V. VI

System Description: GRAVITY CHAMBERED

Repair System Description: PUMP CHAMBERED

Maintenance Agreement Required: ☐ Yes ☑ No

☑ House/Mod. Home No. Bedrooms 4

☐ Mobile Home No. Bathrooms 2.5

☐ Business No. Employees ____

☐ Other _____

☑ Slab ☐ Crawl Space ☐ Basement w/plumbing ☐ Basement wo/plumbing


Water Supply: ☐ Individual ☑ Community ☐ Public

Comments:

Comments:

INITIAL SITE SKETCH

1"=60'

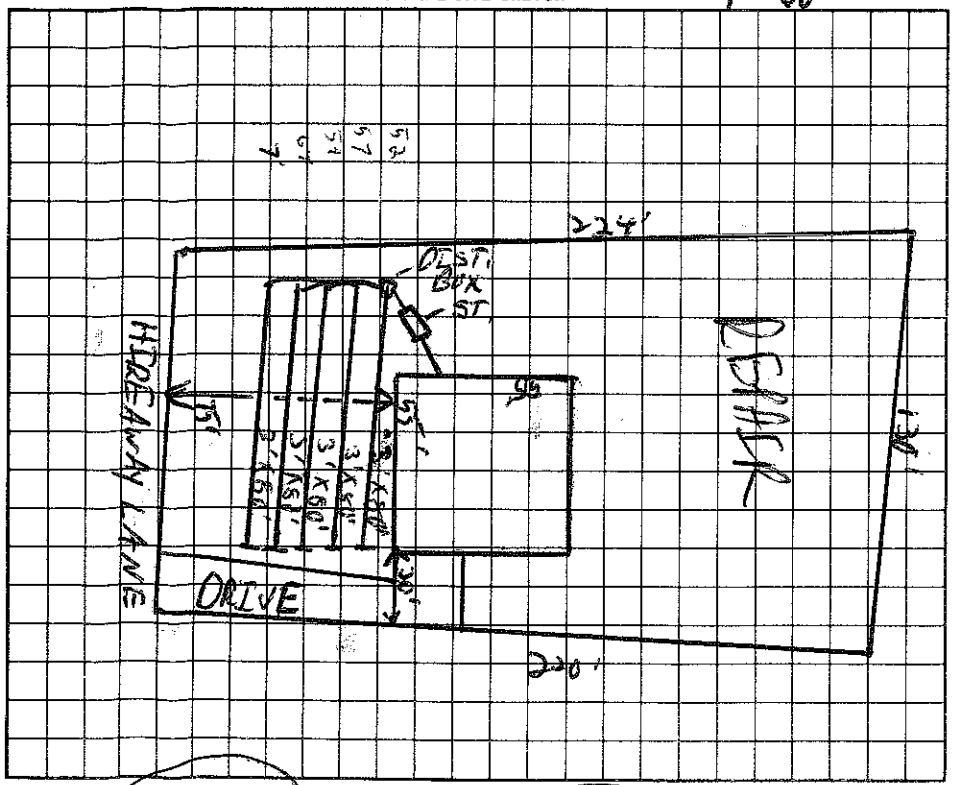

AS BUILT SKETCH

SAME AS SITE SKETCH

I understand that this permit can be suspended or revoked if any false information is supplied toward securing the permit/any unauthorized changes are made to the site/any unauthorized changes are made in the installation of the system.

Signed: _____

Installed by: ROWAN SEPTIC

Improvement Permit by: C. Blackburn EHST date 8/12/96

CONSTRUCTION ~~Existing System Inspection by:~~ C. Blackburn EHST date 8/12/96

AUTHORIZATION

Certificate of Completion by: _____ date _____

Operation Permit by: C. Blackburn EHST date 2/17/97

HEALTH DEPT. COPY: WHITE INSPECTION COPY (FINAL): GREEN OWNER COPY (FINAL): YELLOW INSPECTION COPY (INITIAL): PINK OWNER COPY (INITIAL): GOLD