IREDELL COUNTY HEALTH DEPARTMENT

→ Authorization to Construct -- (2:00) -

STATESVILLE 704-878-5305 MOORESVILLE 704-664-5281

IMPROVEMENT PERMIT / CERTIFICATE OF COMPLETION / OPERATION PERMIT / EXISTING SYSTEM INSPECTION

PROPERTY DESCRIPTION NO. 23224 DATE 7/1/96 TAX MAP NO. Pt of 2544 80 Watershed: ☑ Yes ☐ No

OWNER OR CONTRACTOR Steven P. Hunter PHONE: Business 4638-86-1183 Home 895-3765

ADDRESS ~~[redacted]~~ 19415-A IRE Norman Square Cornelius NC 28031

LOCATION Perth Rd - TR Hideaway Ln 3rd lot on Rt

SUBDIVISION Harborview BLOCK / SECTION I LOT 3 LOT AREA .69 ac SITE CLASS. PS DESIGN FLOW 300gpd L.T.A.R. 3 bed/1+2

Septic Tank: 1000 Gallons; STB 825 Date 12/17/96

Pump Tank: ____ Gallons; PT ____ Date ____

Pump Make: ____ Model ____ Serial No. ____

Nitrification Field: No. Fields 1 Square Feet 900 Linear Feet 300

No. Lines @ 3 Trench Width 36" Max Trench Bottom Depth 36" Gravel Depth N/A

☑ New System ☐ Repair System Type: I, II, III, IV, V, VI

System Description: Gravity Chamber

Repair System Description: Pump Chamber

Maintenance Agreement Required: ☐ Yes ☑ No

☑ House/Mod. Home No. Bedrooms 3

☐ Mobile Home No. Bathrooms 2.5

☑ Business No. Employees ____

☐ Other ____

☐ Slab ☑ Crawl Space ☐ Basement w/plumbing ☐ Basement wo/plumbing


Water Supply: ☐ Individual ☑ Community ☐ Public

Comments: PO form accredited to $50 Bedroom Fee.

Comments:

installed as drawn.

INITIAL SITE SKETCH 1"=60'

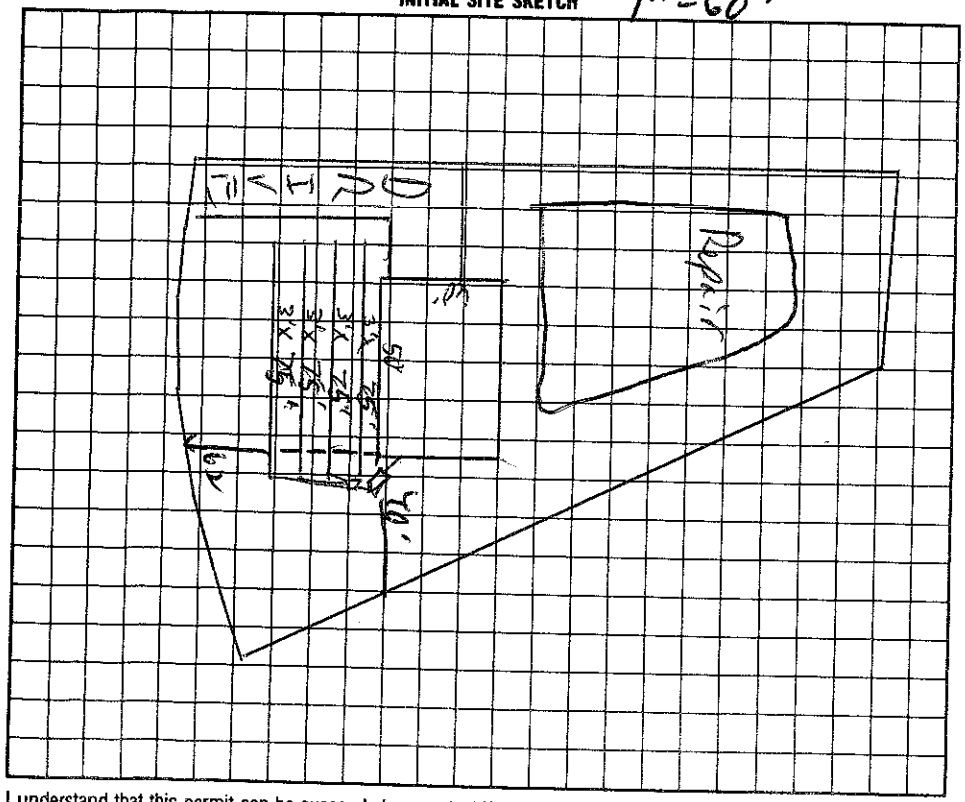

AS BUILT SKETCH

I understand that this permit can be suspended or revoked if any false information is supplied toward securing the permit/any unauthorized changes are made to the site/any unauthorized changes are made in the installation of the system.

Signed: Steve P Hunter

Improvement Permit by: [signature] EHS date 7/1/96

Existing System Inspection by: [signature] EHS date 3/3/96

Installed by: Rowan Septic Tank

Certificate of Completion by: ____ date ____

Operation Permit by: Wesley Parks RS. date 2/26/97

HEALTH DEPT. COPY: WHITE INSPECTION COPY (FINAL): GREEN OWNER COPY (FINAL): YELLOW INSPECTION COPY (INITIAL): PINK OWNER COPY (INITIAL): GOLD