IREDELL COUNTY HEALTH DEPARTMENT

→ AUTHORIZATION TO CONSTRUCT

(3:30)

STATESVILLE 704-878-5305 MOORESVILLE 704-664-5281

IMPROVEMENT PERMIT / ~~CERTIFICATE OF COMPLETION~~ / OPERATION PERMIT / EXISTING SYSTEM INSPECTION

PROPERTY DESCRIPTION NO. 23225 DATE 8/12/96 TAX MAP NO. pf of 25A 80 Watershed: ☑ Yes ☐ No

OWNER OR CONTRACTOR STUMPY CREEK LLC PHONE: Business 633-6124 ~~Home~~ 4638-86-1233

ADDRESS 614 N MAIN SALISBURY NC 28144

LOCATION 150 W - TR PERTH RD - TL HIDEAWAY LN - 4TH LOT ON RT

SUBDIVISION HARBOR VIEW BLOCK / SECTION 1 LOT 4 LOT AREA ≈ .6 AC SITE CLASS. P5 DESIGN FLOW 480 GPD L.T.A.R. 36 PD/FT ±

Septic Tank: 1000 Gallons; STB 625 Date 1/1/97

Pump Tank: _____ Gallons; PT _____ Date _____

Pump Make: _____ Model _____ Serial No. _____

Nitrification Field: No Fields 1 Square Feet 1200 Linear Feet 400

No Lines 5 Trench Width 36" Max Trench Bottom Depth ≈ 24" Gravel Depth N/A

☑ New System ☐ Repair System Type: I, II, III, IV, V, VI

System Description: GRAVITY CHAMBERED

Repair System Description: PUMP CHAMBERED

Maintenance Agreement Required: ☐ Yes ☐ No

☑ House/Mod. Home No. Bedrooms 4 3

☐ Mobile Home No. Bathrooms 2.5

☐ Business No. Employees ____

☐ Other _____


☑ Slab ☐ Crawl Space ☐ Basement w/plumbing ☐ Basement wo/plumbing

Water Supply: ☐ Individual ☑ Community ☐ Public


Comments:

Comments: CHANGED TO 3BR 300 FT ± Chambers Installed

INITIAL SITE SKETCH

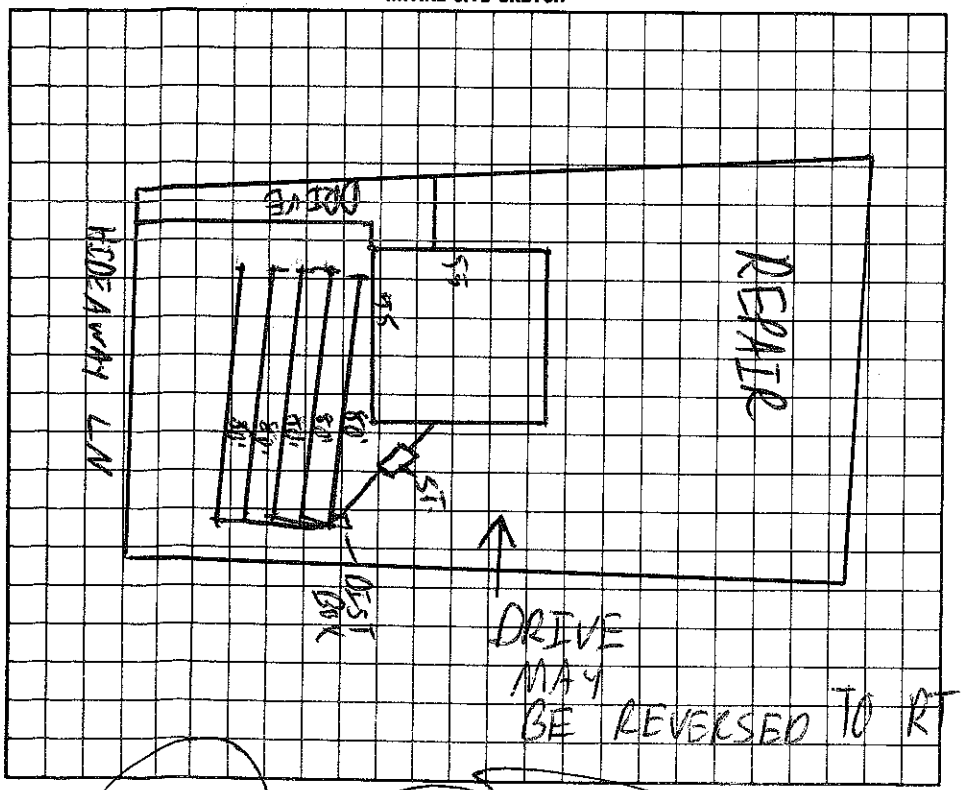

AS BUILT SKETCH 1" = 60'

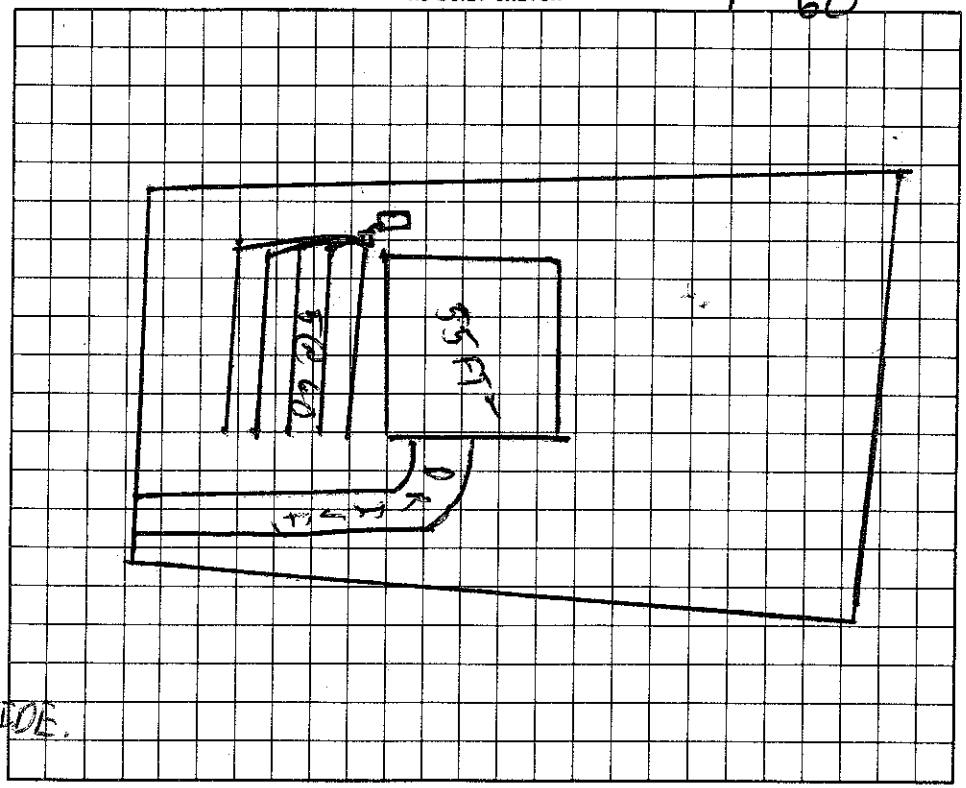

I understand that this permit can be suspended or revoked if any false information is supplied toward securing the permit/any unauthorized changes are made to the site/any unauthorized changes are made in the installation of the system.

Signed: _____

Installed by: ROWAN SEPTIC

Improvement Permit by: C. Ray Teem EHSI date 8/12/96

(CONSTRUCTION AUTHORIZATION)

Existing System Inspection by: C. Ray Teem EHSI date 8/12/96

Certificate of Completion by: _____ date _____

Operation Permit by: C. Ray Teem date 2/4/97

HEALTH DEPT. COPY: WHITE INSPECTION COPY (FINAL): GREEN OWNER COPY (FINAL): YELLOW INSPECTION COPY (INITIAL): PINK OWNER COPY (INITIAL): GOLD