# IREDELL COUNTY HEALTH DEPARTMENT

Const. Auth. STATESVILLE 704-878-5305 MOORESVILLE 704-664-5281

## IMPROVEMENT PERMIT / ~~CERTIFICATE OF COMPLETION~~ / OPERATION PERMIT / EXISTING SYSTEM INSPECTION

PROPERTY DESCRIPTION NO. 066828 DATE July 29, '97 TAX MAP NO. ~~4636 77 1716~~ 4638-86-2930 Watershed: ☑ Yes ☐ No

OWNER OR CONTRACTOR Stumpy Creek LLC PHONE: Business 633-6124 Home

ADDRESS 614 N. Main St. Salisbury 28144

LOCATION Perth Rd N. TL Wilmbrell 2nd lot on left

SUBDIVISION Harborview BLOCK / SECTION 4 LOT 6 LOT AREA .62 ac SITE CLASS. 15 DESIGN FLOW ~~360~~ gpd L.T.A.R. .3

Septic Tank: 1000 Gallons; STB 625 Date 3/1/98

Pump Tank: _____ Gallons; PT _____ Date _____

Pump Make: _____ Model _____ Serial No. _____

Nitrification Field: No Fields 1 Square Feet 1200 Linear Feet 400

No Lines 5@80' Trench Width 36" Max Trench Bottom Depth ~30" Gravel Depth NA

☑ New System ☐ Repair System Type: I, II, III, IV, V, VI

System Description: gravity ~~chamber~~

Repair System Description: Same Conv.

Maintenance Agreement Required: ☐ Yes ☒ No

☑ House/Mod. Home No. Bedrooms ~~3~~ 4

☐ Mobile Home No. Bathrooms 2.5

☐ Business No. Employees _____

☐ Other _____


☑ Slab ☐ Crawl Space ☐ Basement w/plumbing ☐ Basement wo/plumbing

Water Supply: ☐ Individual ☑ ~~Community~~ ☐ Public

Comments: * ONE inspection port per LATERAL

Comments:

**INITIAL SITE SKETCH**

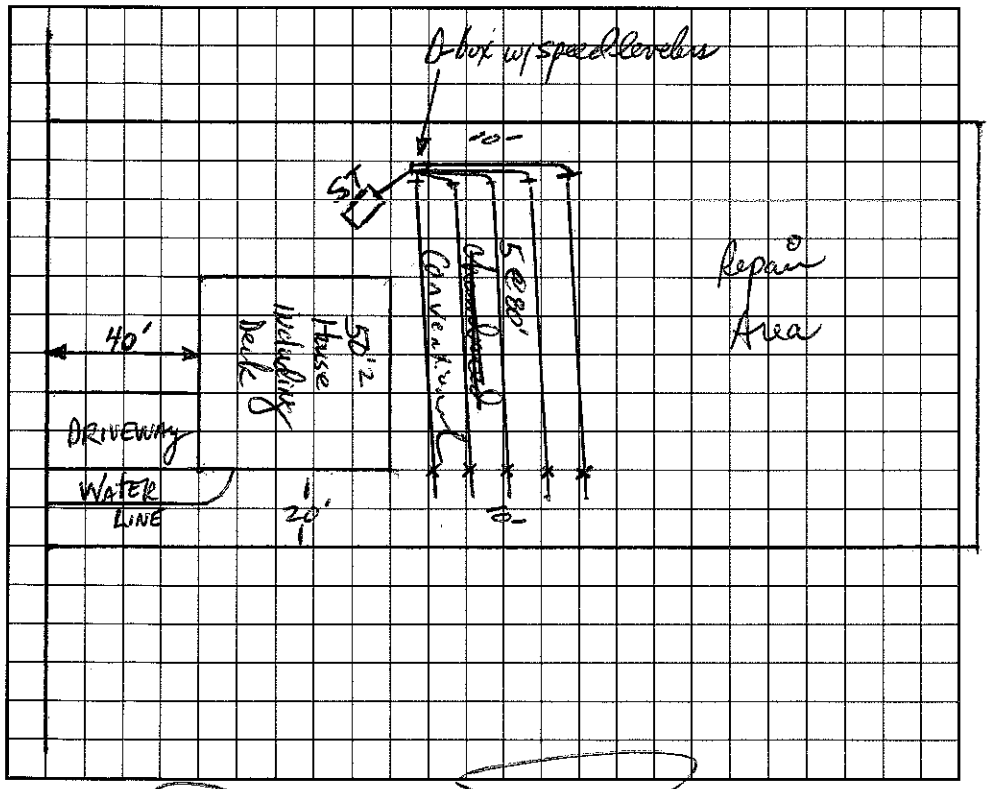


**AS BUILT SKETCH**

I understand ~~that~~ this permit can be suspended or revoked if any false information is supplied toward securing the permit/any unauthorized changes are made to the site/any unauthorized changes are made in the installation of the system. Improvement Permit is valid for 60 months from date of issuance.

Signed: _____

Installed by: ROWAN SEPTIC

Improvement Permit by: DR Hamm, IRS date 7-29-97

Construction Authorization

Existing System Inspection by: DR Hamm, IRS date 10-2-97

Certificate of Completion by: _____ date _____

Operation Permit by: _____ date 5/5/98

HEALTH DEPT. COPY: WHITE INSPECTION COPY (FINAL): GREEN OWNER COPY (FINAL): YELLOW INSPECTION COPY (INITIAL): PINK OWNER COPY (INITIAL): GOLD