# IREDELL COUNTY HEALTH DEPARTMENT

Const. Auth. STATESVILLE 704-878-5305 MOORESVILLE 704-664-5281

(309-8625) 11300

## IMPROVEMENT PERMIT / ~~CERTIFICATE OF COMPLETION~~ / OPERATION PERMIT / EXISTING SYSTEM INSPECTION

PROPERTY DESCRIPTION NO. 0668625 DATE July 28 '97 TAX MAP NO. ~~4638-77-1716~~ 4638-86-3325 Watershed: ☑ ~~Yes~~ ☐ No

OWNER OR CONTRACTOR Stumpy Creek LLC / L. Shawn Ogden PHONE: Business _____ Home _____

ADDRESS 6411 S Main Salisbury NC 28144

LOCATION Turkey Creek Rd N on left past Hideaway Lane

SUBDIVISION Hardenwood BLOCK / SECTION 4 LOT 2 LOT AREA ±6 Ac SITE CLASS. RS DESIGN FLOW 480 gpd L.T.A.R. ~3

Septic Tank: 1000 Gallons; STB 1012 Date 9-19-00

Pump Tank: _____ Gallons; PT _____ Date _____

Pump Make: _____ Model _____ Serial No. _____

Nitrification Field: No Fields 1 Square Feet 1200 Linear Feet 400

No Lines 4@100' Trench Width 36" Max Trench Bottom Depth 30" Gravel Depth #4

☑ New System ☐ Repair System Type: I, II, III, IV, V, VI

System Description: gravity trenches

Repair System Description: ~~gravity~~ pumped pond block

Maintenance Agreement Required: ☐ Yes ☐ No

☑ House/Mod. Home No. Bedrooms 4

☐ Mobile Home No. Bathrooms 2.5

☐ Business No. Employees _____

☐ Other _____


☐ Slab ☑ Crawl Space ☐ Basement w/plumbing ☐ Basement wo/plumbing

Water Supply: ☐ Individual ☑ Community ☐ Public


Comments: Exit plumbing at existing grade. Do not excavate within lower house foundation or ~~[illegible]~~ from drainfield area.
* ONE Inspection port per Lateral

Comments: Filter & riser installed.

### INITIAL SITE SKETCH

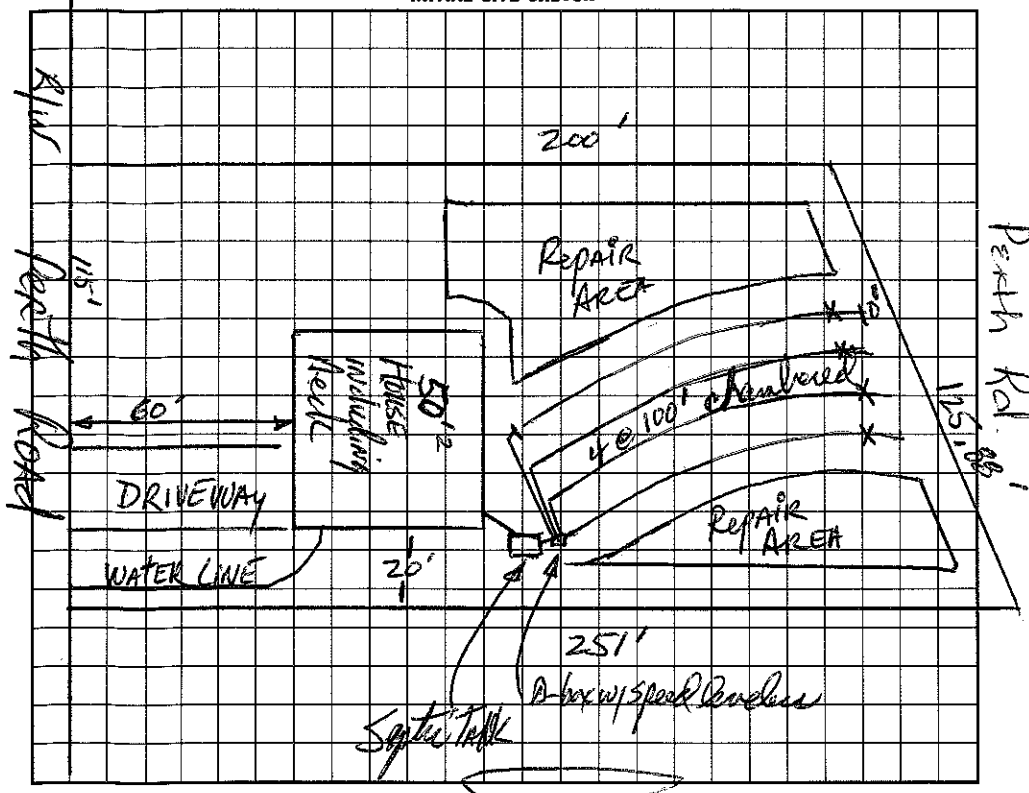


### AS BUILT SKETCH

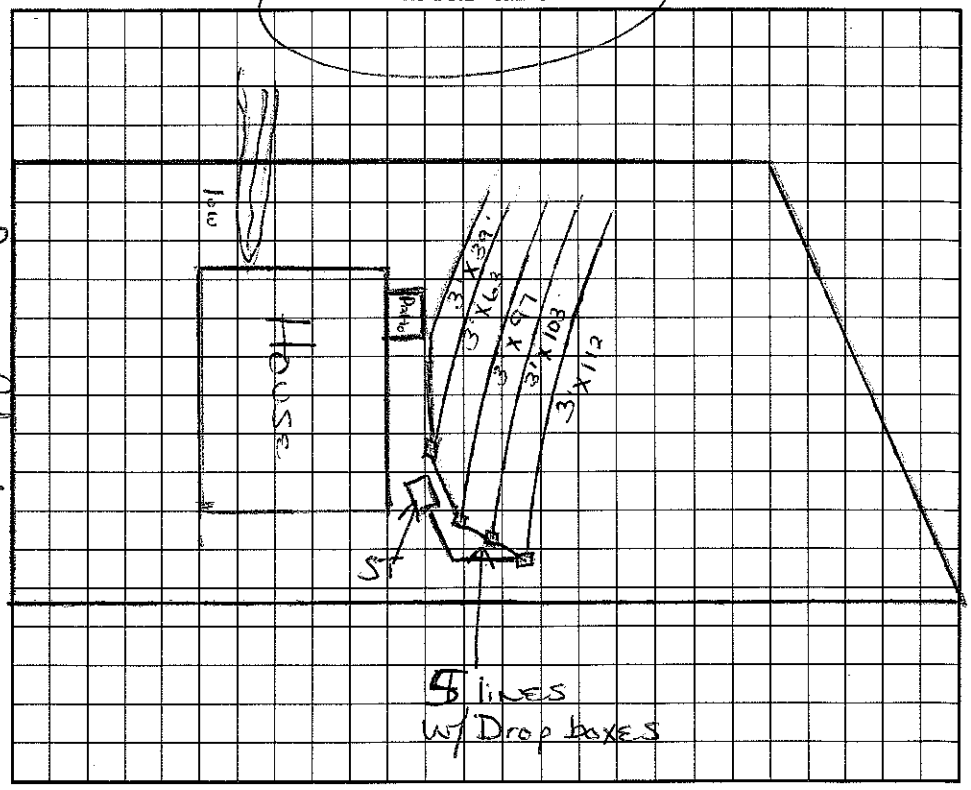


I understand that this permit can be suspended or revoked if any false information is supplied toward securing the permit/any unauthorized changes are made to the site/any unauthorized changes are made in the installation of the system. Improvement Permit is valid for 60 months from date of issuance.

Signed: _____

Improvement Permit by: [signature] RS date 7-28-97

~~Construction~~ Existing System Inspection by: [signature] RS date 11/13/2000

Installed by: Richard Apperson

Certificate of Completion by: [signature] RS date 11/26/2000

Operation Permit by: [signature] RS date 11/26/2000

~~Final Letter Sent~~ HEALTH DEPT. COPY: WHITE INSPECTION COPY (FINAL): GREEN OWNER COPY (FINAL): YELLOW INSPECTION COPY (INITIAL): PINK OWNER COPY (INITIAL): GOLD