IREDELL COUNTY HEALTH DEPARTMENT

Const. Auth. STATESVILLE 704-878-5305 MOORESVILLE 704-664-5281

11 of

IMPROVEMENT PERMIT / ~~CERTIFICATE OF COMPLETION~~ / OPERATION PERMIT / EXISTING SYSTEM INSPECTION

PROPERTY DESCRIPTION NO. 066826 DATE July 18, '97 TAX MAP NO. ~~4638-77-1746~~ 4638-86-3406 Watershed: ☑ Yes ☐ No

OWNER OR CONTRACTOR Stumpy Creek LLC / Jeff Rogers PHONE: Business 632-6124 Home

ADDRESS 614 N. Main Salisbury 28144 WS4CA

LOCATION Perth Rd N. on left past Hideaway Lane

SUBDIVISION Harborview BLOCK / SECTION 4 LOT 3 LOT AREA .74 AC SITE CLASS. RS DESIGN FLOW 480gpd L.T.A.R. .3

Septic Tank: 1000 Gallons; STB 249 Date ~~10/21/97~~ 10/24/97 ☑ New System ☐ Repair System Type: I II III IV V VI Conventional

Pump Tank: Gallons; PT Date System Description: *** gravity ~~conventional~~

Pump Make: Model Serial No. Repair System Description: gravity/pumped chambered

Nitrification Field: No Fields 1 Square Feet 1200 Linear Feet 400 Maintenance Agreement Required: ☐ Yes ☑ No Conventional

No Lines 4@100' Trench Width 36" Max Trench Bottom Depth 36" Gravel Depth NA

☑ House/Mod. Home No. Bedrooms ~~4~~ 3

☐ Mobile Home No. Bathrooms 2½

☐ Business No. Employees

☐ Other


☐ Slab ☑ Crawl Space ☐ Basement w/plumbing ☐ Basement wo/plumbing

Water Supply: ☐ Individual ☑ Community ☐ Public


Comments: * ONE Inspection port per Lateral
*** House must be built on a high crawlspace or elevated pad, otherwise a pump will be required on the septic system.

Comments: * Changed from 4 Bedroom to 3 Bedroom Hse. Septic System changed From Grav/Chambered (Type III) to Grav. Conventional (Type II) MJE 11/7/97
Bedroom Fee $50.00 Pd 11/7/97

INITIAL SITE SKETCH

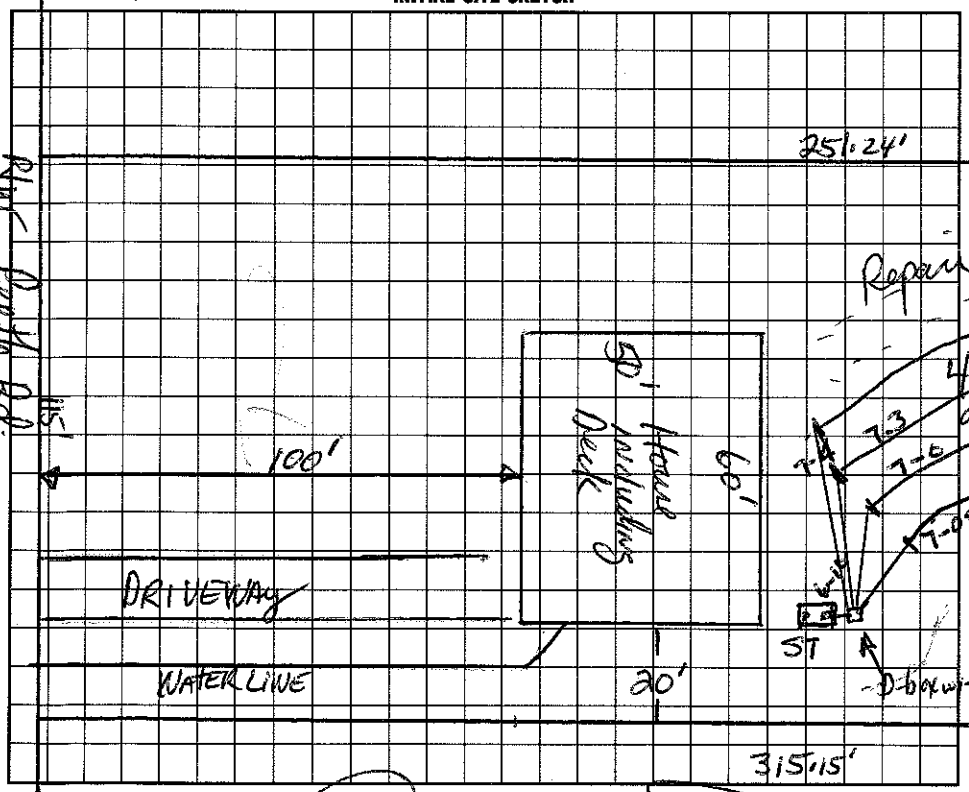

AS BUILT SKETCH

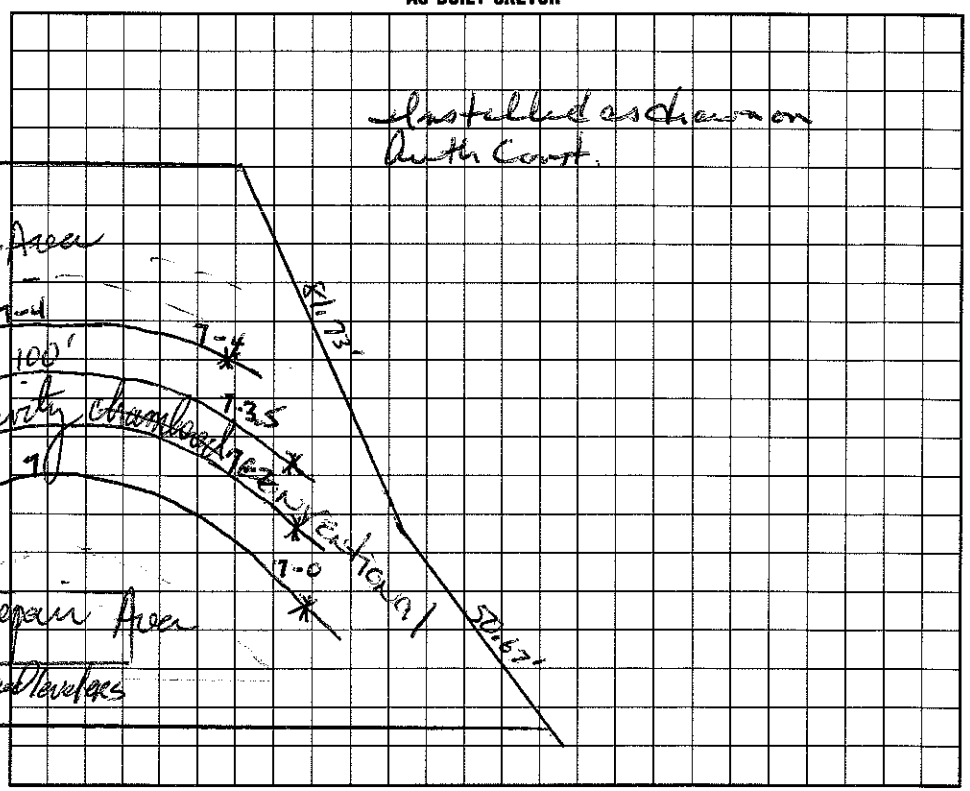

I understand that this permit ~~can be~~ suspended or revoked if any false information is supplied toward securing the permit/any unauthorized changes are made to the site/any unauthorized changes are made in the installation of the system. Improvement Permit is valid for 60 months from date of issuance.

Signed:

Improvement Permit by: date 7-18-97

~~Existing System~~ Construction Inspection by: date 10-24-97

Installed by: Cladius Morrison

Certificate of Completion by: Wesley Sparks RS. date 11/12/97

Operation Permit by: Wesley Sparks RS. date 11/12/97

HEALTH DEPT. COPY: WHITE INSPECTION COPY (FINAL): GREEN OWNER COPY (FINAL): YELLOW INSPECTION COPY (INITIAL): PINK OWNER COPY (INITIAL): GOLD