IREDELL COUNTY HEALTH DEPARTMENT

Statesville Office (704) 878-5305 Mooresville Office (704) 660-3625 PERMIT # 2100211051

IMPROVEMENT PERMIT / AUTHORIZATION TO CONSTRUCT / OPERATION PERMIT / EXISTING SYSTEM

PIN # 4638-86-5874

APPLICANT: Sue Clohecy APPLICANT ADDRESS: 135 Harbor Landing Dr Mooresville NC 28117

SITE ADDRESS: 135 Harbor Landing Dr PHONE: ALT. PHONE:

SITE DIRECTIONS: Hwy 150 W, TR on Perth, TR on Erne, TR on Harbor Landing, 2nd Lot on R

SUBDIVISION: Harbor Landing SECTION: 3 LOT # 36 LOT AREA: 0.55 ac DESIGN FLOW: 360 gpd L.T.A.R.: 0.3

Septic Tank 1000 (gal) STB 1947 Date 8-4-15
Pump Tank (gal) PT Date
Pump Make Model Serial #
Nitrification Fields 1 # Lines 1 Linear Ft: 100
Trench Width 36" Max. Trench Bottom Depth 36" Gravel Depth N/A

☐ New System ☐ Repair ☐ Expansion System Type: I II (III) IV V VI
System Description: Existing Chambers + 25% Reduction
Repair System Description: LPPBPS
Maintenance Agreement Required: ☐ YES ☑ NO
☑ GRAVITY ☐ PRESSURE

☐ Residence ☐ Business ☑ Other ☐ Slab ☐ Basement w/plumbing
No. Bedrooms 3 No. Persons 6 No. Employees
☐ Crawl Space ☐ Basement w/o plumbing

Water Supply: ☐ Private ☐ Public ☑ Community

Comments / Conditions: * Pump, crush and backfill existing ST to be abandoned.

Installed QuickPOOL

INITIAL SITE SKETCH

SEE DESIGN BY MICHAEL ATHANAS & ASSOCIATES

(Approved 6-8-15)

AS BUILT SKETCH

Permit can be suspended or revoked if any false information is supplied toward securing the permit / any unauthorized changes are made to the site / any unauthorized changes are made in the installation of the system. **CONTACT A LOCATOR SERVICE PRIOR TO ANY EXCAVATION**

☐ **IMPROVEMENT PERMIT** *with plat valid without expiration.* ☑ **IMPROVEMENT PERMIT** *with site plan valid for 60 mos.* ☑ **AUTHORIZATION TO CONSTRUCT** *valid for period equal to IMPROVEMENT PERMIT--not to exceed 60 mo.*

Owner / Applicant Signature: Susan A Clohecy Date: 6/23/15 Installed by: Hallman Construction


IMPROVEMENT PERMIT by: [signature] Date: 6-8-15 OPERATION PERMIT by: Marie H Cohen RS Date: 9/21/15

AUTHORIZATION TO CONSTRUCT by: [signature] Date: 6-8-15 Existing System Inspected by: Date:

Health Dept. Copy - WHITE Applicant (Final Approval) - YELLOW Applicant (Conditional Approval) - PINK

Curve	Radius	Length	Chord	Chord Bear.
C1	275.20'	65.72'	65.56'	S 09°35'57" E

Course	Bearing	Distance
L1	S 02°35'55" E	32.95'

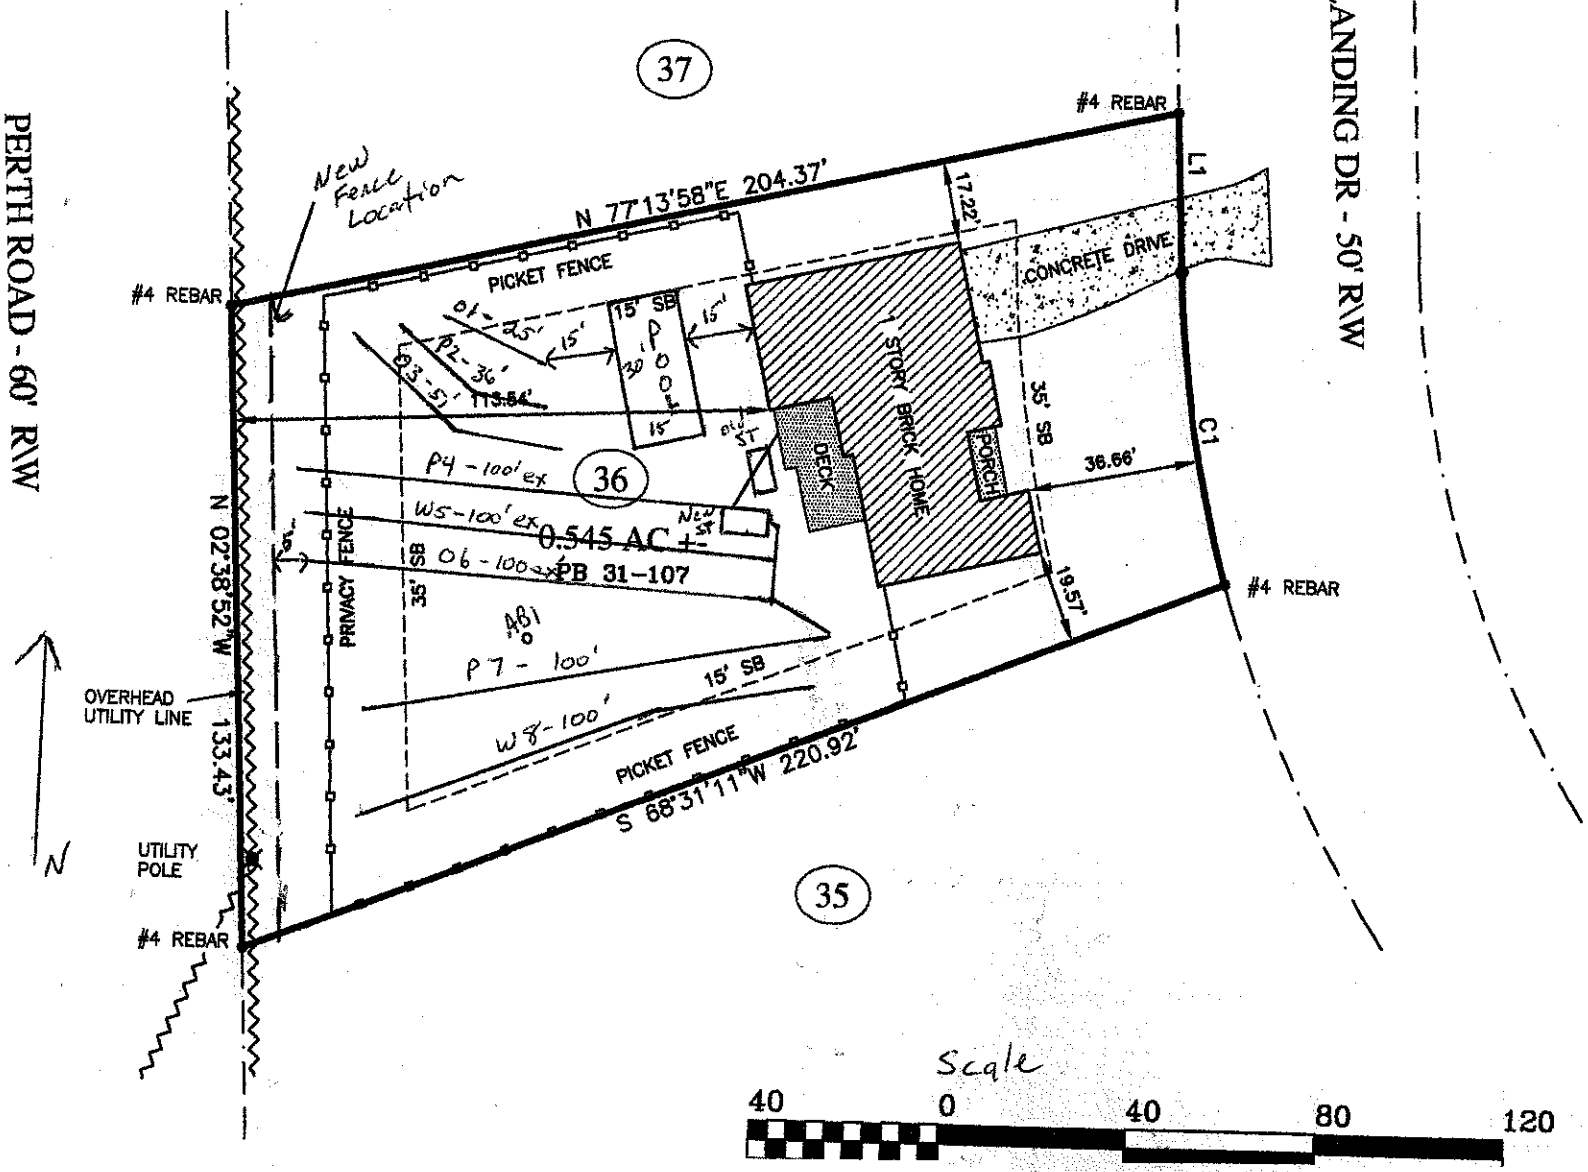

Approved 6-8-15 RP

SUS

BEING LOT

DAVIDSO

DED

CH
ROI
370
P.O. E

I, ROBERT J.
DRAWN FROM
SUPERVISION
THAT THE
EXCEEDS 1:1(
IN ACCORDAN
WITNESS MY (

Robert

PROFESSIONA

SURV. BY: WT

VICINITY

