# IREDELL COUNTY HEALTH DEPARTMENT

STATESVILLE 704-878-5305 MOORESVILLE 704-664-5281

## IMPROVEMENT PERMIT / AUTHORIZATION TO CONSTRUCT / OPERATION PERMIT / EXISTING SYSTEM INSPECTION

PERMIT# 072592 PIN# ~~4639 73 4550 (pt.)~~ 4638-86-5874 DATE July 23, '98

OWNER OR CONTRACTOR Stumpy Creek LLC PHONE: Business 633-6124 Home

ADDRESS 614 N. Main St Salisbury N.C. 28144

LOCATION Perth Rd. N. TR Sagemore TR Harbor Landing Dr. on left

SUBDIVISION Harbor Landing BLOCK / SECTION III LOT 36 LOT AREA 23,728 sq ft SITE CLASS PS DESIGN FLOW 480 gpd L.T.A.R. .3

Septic Tank: 1000 Gallons; STB 825 Date 9/24/99
Pump Tank: Gallons; PT Date
Pump Make: Model Serial No.
Nitrification Field: No Fields 1 Square Feet 1200 Linear Feet ~~300~~ 300
No Line 3 @ 100' Trench Width 36" Max Trench Bottom Depth ~~24"~~ 24"

☑ New System ☐ Repair System Type: I, II, (III), IV, V, VI
System Description: Gravity 25% Reduction
Repair System Description: Same
Maintenance Agreement Required: ☐ Yes ☑ No

☑ House/Mod. Home No. Bedrooms 4
☐ Mobile Home No. Bathrooms 3
☐ Business No. Employees
☐ Other

Gravel Depth N/A ☐ Slab ☑ Crawl Space ☐ Basement w/plumbing ☐ Basement wo/plumbing


Water Supply: ☐ Individual ☑ ~~Public~~ ☐ ~~Community~~

Comments:/Conditions: * ONE INSPECTION/OBSERVATION PORT PER LATERAL
REMOVE old FARM BURNS/TERRACES

Comments:/Conditions: 12/16/99 Bedrooms counted, 3 BDRM HOUSE
3 lines 100'x3' installed AcWS

1" = 60'

INITIAL SITE SKETCH

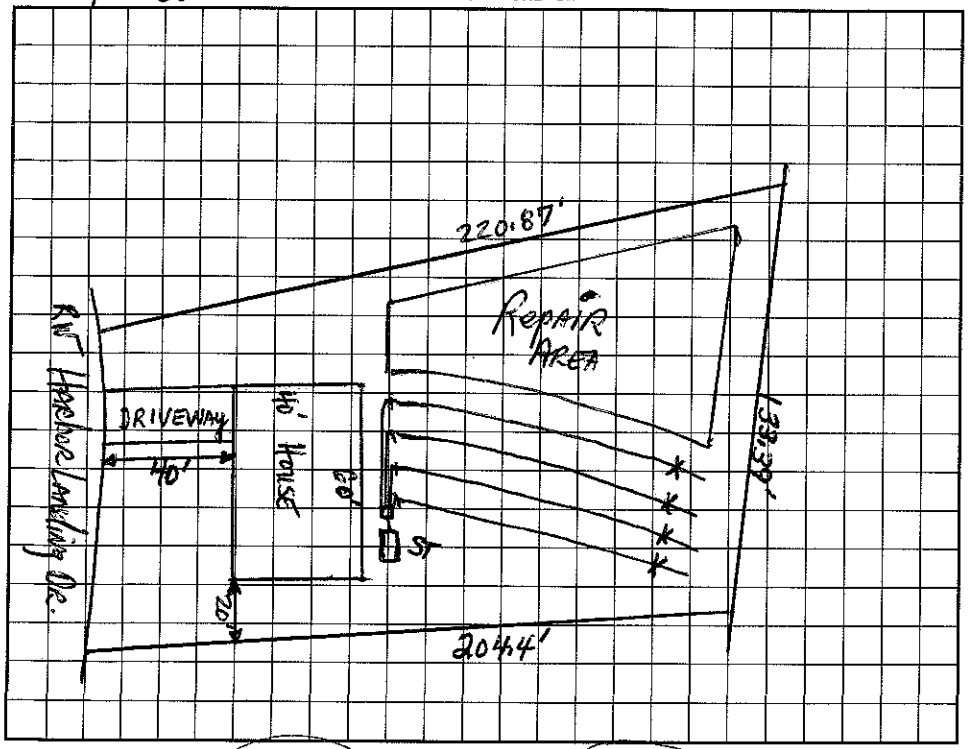


AS BUILT SKETCH

I understand that this permit can be suspended or revoked if any false information is supplied toward securing the permit/any unauthorized changes are made to the site/any unauthorized changes are made in the installation of the system. Improvement Permit with plat valid without expiration. Improvement Permit with site plan valid for sixty months. Authorization to Construct is valid for a period equal to that of Improvement Permit – not to exceed sixty months.

Signed: * date

Improvement Permit by: Wesley Lyons RS date 7-23-98

Authorization to Construct by: Wesley Lyons RS date 9/2/99

Installed by: Rowan Septic Tanks

Operation Permit by: Wesley Lyons RS date 12/16/99

Existing System Inspection by: date

HEALTH DEPT. COPY: WHITE INSPECTION COPY (FINAL): GREEN OWNER COPY (FINAL): YELLOW INSPECTION COPY (INITIAL): PINK OWNER COPY (INITIAL): GOLD