IREDELL COUNTY HEALTH DEPARTMENT


ENVIRONMENTAL HEALTH DIVISION

PAGE 2: *SITE PLAN WORKSHEET*

SEE THE "SAMPLE SITE PLAN" BELOW. *INCOMPLETE SITE PLANS WILL BE RETURNED TO YOU FOR COMPLETION AND MAY RESULT IN A DELAY IN THE ISSUANCE OF YOUR SEPTIC SYSTEM PERMIT*!!!

Place an (X) beside each item as you complete the site plan:

- ( ) **Property Line measurements are clearly identified**
- ( ) **All proposed structures are indicated**
- ( ) **Front and side setbacks from property line**
- ( ) **Preferred driveway location and well location**
- ( ) **Area you prefer your septic system to be placed**
- ( ) **North arrow, or other sufficient indicator of direction**

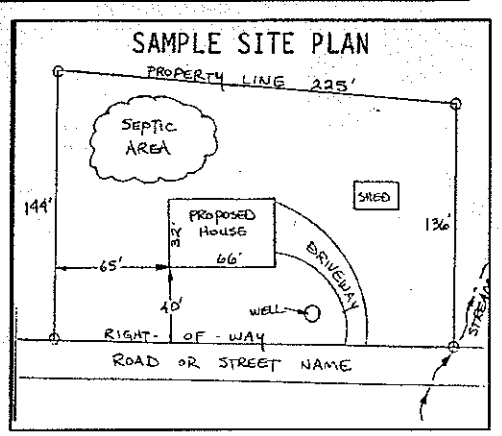

Circle N/A on the following if appropriate:

Location of septic systems and wells within 100' of your property	**N/A**
Location of easements and rights of ways on your property	**N/A**
Location of any designated wetlands on the property	**N/A**

USE THIS SPACE TO DRAW YOUR SITE PLAN

Show: proposed house or business footprint, wells, water lines, patios, pools and decks, and any other item that will occupy space on the site

See Attached Plan

Signature: _____ 6/4/2014

Property owner or owner's legal representative signature (SIGNATURE REQUIRED) **DATE**

IREDELL COUNTY HEALTH DEPARTMENT

STATESVILLE 704-878-5305 MOORESVILLE 704-664-5281

IMPROVEMENT PERMIT / AUTHORIZATION TO CONSTRUCT / OPERATION PERMIT / EXISTING SYSTEM INSPECTION

PERMIT# 072592 PIN# ~~4639-73-4550 (pt.)~~ 4638-86-5874 DATE July 23, '98

OWNER OR CONTRACTOR Stumpy Creek LLC PHONE: Business 633-6124 Home

ADDRESS 614 N. Main St Salisbury N.C. 28144

LOCATION Perth Rd. N. TR Sagemore TL Harbor Landing Dr. ON left

SUBDIVISION Harbor Landing BLOCK / SECTION III LOT 36 LOT AREA 23,728 SF SITE CLASS. PS DESIGN FLOW 480gpd L.T.A.R. 1.3

Septic Tank: 1000 Gallons; STB 82.5 Date 9/24/98

Pump Tank: Gallons; PT Date

Pump Make: Model Serial No.

Nitrification Field: No Fields 1 Square Feet 1200 Linear Feet ~~300~~ 300

No Lines 3 @ 100' Trench Width 36" Max Trench Bottom Depth 24"

☑ New System ☐ Repair System Type: I, II, (III), IV, V, VI

System Description: GRAVITY 25% Reduction

Repair System Description: SAME

Maintenance Agreement Required: ☐ Yes ☑ No

☑ House/Mod. Home No. Bedrooms 4/3

☐ Mobile Home No. Bathrooms 3

☐ Business No. Employees

☐ Other

Water Supply: ☐ Individual ☐ Public ☐ Community

Gravel Depth N/A ☐ Slab ☑ Crawl Space ☐ Basement w/plumbing ☐ Basement wo/plumbing

Comments:/Conditions: * ONE INSPECTION/OBSERVATION PORT PER LATERAL


Remove old FARM BURNS/TERRACES

Comments:/Conditions: 12/16/98 Bedrooms counted, 3 BDRM House

3 lines 100'x3' installed ACCS

1" = 60'

INITIAL SITE SKETCH

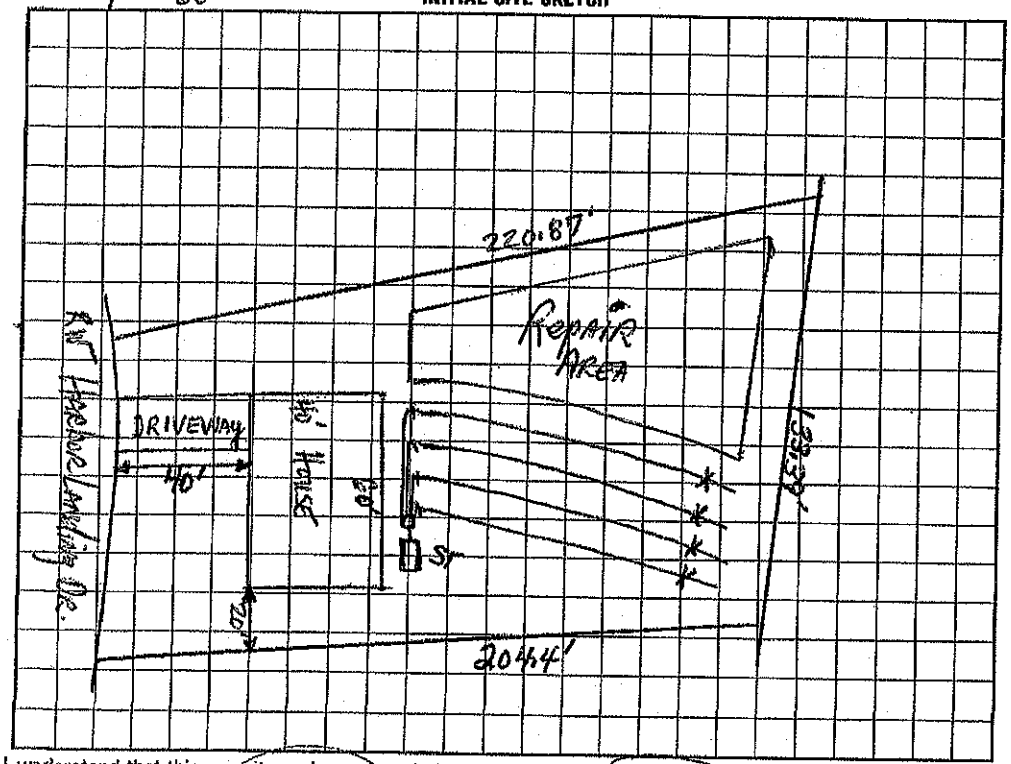

AS BUILT SKETCH

I understand that this permit can be suspended or revoked if any false information is supplied toward securing the permit/any unauthorized changes are made to the site/any unauthorized changes are made in the installation of the system. Improvement Permit with plat valid without expiration. Improvement Permit with site plan valid for sixty months. Authorization to Construct is valid for a period equal to that of Improvement Permit – not to exceed sixty months.

Signed: * date

Improvement Permit by: [signature] date 7-23-98

Authorization to Construct by: [signature] date 9/1/98

Installed by: Rowan Septic Tanks

Operation Permit by: Wesley Sparks RS date 12/16/98