3pm Rowan ST

IREDELL COUNTY HEALTH DEPARTMENT

STATESVILLE 704-878-5305 MOORESVILLE 704-664-5281

IMPROVEMENT PERMIT / AUTHORIZATION TO CONSTRUCT / OPERATION PERMIT / EXISTING SYSTEM INSPECTION

PERMIT# 072593 PIN# ~~4639 73 4550 (pt.)~~ 4638-86-5975 DATE July 24, '98

OWNER OR CONTRACTOR Stumpy Creek LLC PHONE: Business Home

ADDRESS 614 N. Main St Salisbury N.C. 28625

LOCATION Peeth Rd. N. TR Harbor Landing Dr. on Right

SUBDIVISION Harbor Landing BLOCK / SECTION II LOT 37 LOT AREA 23728 ft² SITE CLASS. 15 DESIGN FLOW 360 gpd L.T.A.R. .3

Septic Tank: 1000 Gallons; STB Date

Pump Tank: Gallons; PT Date

Pump Make: Model Serial No.

Nitrification Field: No Fields 1 Square Feet 900 Linear Feet 300

No Lines 4@75' Trench Width 36" Max Trench Bottom Depth 24"

☑ New System ☐ Repair System Type: I, II, (III), IV, V, VI,

System Description: Gravity 25% Reduction

Repair System Description: Grav/Pumped 25% Red.

Maintenance Agreement Required: ☐ Yes ☑ No

Gravel Depth NA

☑ House/Mod. Home No. Bedrooms 3

☐ Mobile Home No. Bathrooms 2

☐ Business No. Employees

☐ Other

☐ Slab ☑ Crawl Space ☐ Basement w/plumbing ☐ Basement wo/plumbing

Water Supply: ☐ Individual ☑ Public ☐ Community


Comments:/Conditions: * ONE inspection/observation port per Lateral

Remove any old Berms/Terraces

Comments:/Conditions:

1"=60'

INITIAL SITE SKETCH

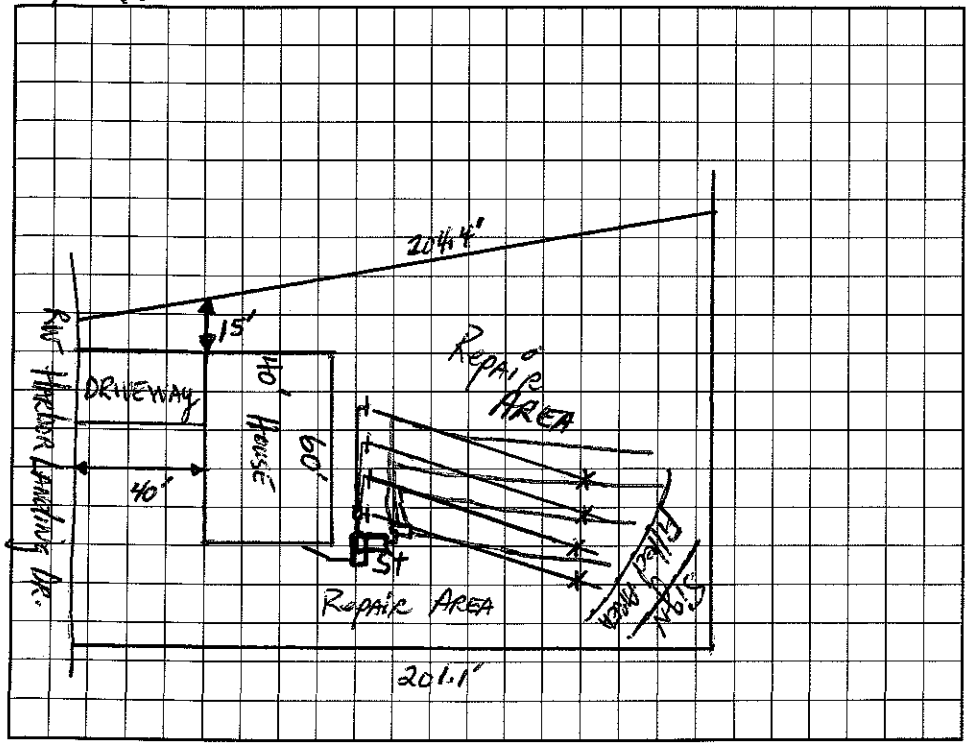

AS BUILT SKETCH

I understand that this permit can be suspended or revoked if any false information is supplied toward securing the permit/any unauthorized changes are made to the site/any unauthorized changes are made in the installation of the system. Improvement Permit with plat valid without expiration. Improvement Permit with site plan valid for sixty months. Authorization to Construct is valid for a period equal to that of Improvement Permit – not to exceed sixty months.

Signed: * date

Improvement Permit by: RS date 7-24-98

Authorization to Construct by: date 10/28/99

Installed by: Rowan Septic Tank

Operation Permit by: RS date 6/19/00

Existing System Inspection by: date

HEALTH DEPT. COPY: WHITE INSPECTION COPY (FINAL): GREEN OWNER COPY (FINAL): YELLOW INSPECTION COPY (INITIAL): PINK OWNER COPY (INITIAL): GOLD