4638866079

IREDELL COUNTY HEALTH DEPARTMENT

STATESVILLE 704-878-5305 MOORESVILLE 704-664-5281

IMPROVEMENT PERMIT / CERTIFICATE OF COMPLETION / OPERATION PERMIT / EXISTING SYSTEM INSPECTION

PROPERTY DESCRIPTION NO. 17571 DATE 12/13/93 TAX MAP NO. 25-3A-24-25C Watershed: ☐ Yes ☐ No

OWNER OR CONTRACTOR JAMES A DAVIDSON PHONE: Business _____ Home 664-2199

ADDRESS Rt 4 Box 86 MOORESVILLE, NC.

LOCATION PERTH RD, (R) JUST PAST pump station bridge to shop b/l on (L)

SUBDIVISION CL+T BLOCK / SECTION 14 LOT 24 & 25 (D) AREA 1.79Ac SITE CLASS. P DESIGN FLOW 250 GPD L.T.A.R 25: 3

Septic Tank: 900 Gallons; STB 828 Date 3/9/94

Pump Tank: _____ Gallons; PT _____ Date _____

Pump Make: _____ Model _____ Serial No. _____

Nitrification Field: No Fields 1 Square Feet 200 Linear Feet 66

No Lines 1 Trench Width 3' Max Trench Bottom Depth 36 Gravel Depth 12"

☑ New System ☐ Repair System Type: I, II, III, IV, V, VI

System Description: CONV. DIST BOX

Repair System Description: _____

Maintenance Agreement Required: ☐ Yes ☑ No

☐ House/Mod. Home No. Bedrooms ____

☐ Mobile Home No. Bathrooms ____

☐ Business No. Employees ____

☑ Other 1 BATH SHOP/STORAGE

☐ Slab ☑ Crawl Space ☐ Basement w/plumbing ☐ Basement wo/plumbing


Water Supply: ☑ Individual ☐ Community ☐ Public

Comments:


Keep trench field 50' from existing well as shown here.
No deeper than 36" to trench bottom.

Comments:

INITIAL SITE SKETCH

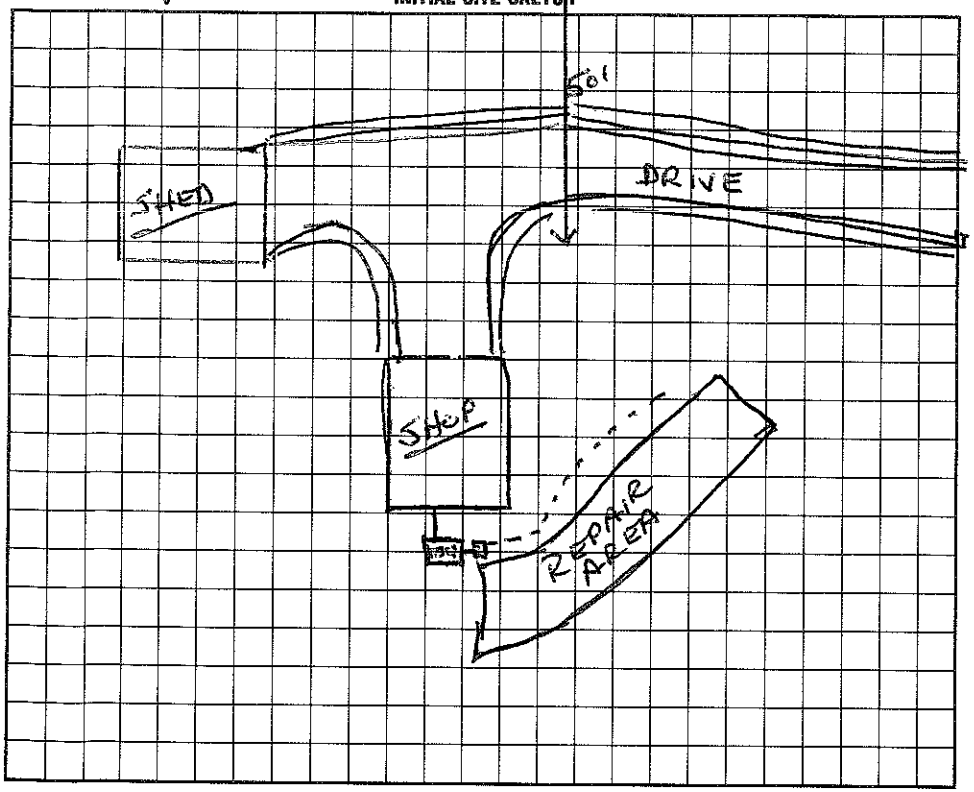

AS BUILT SKETCH

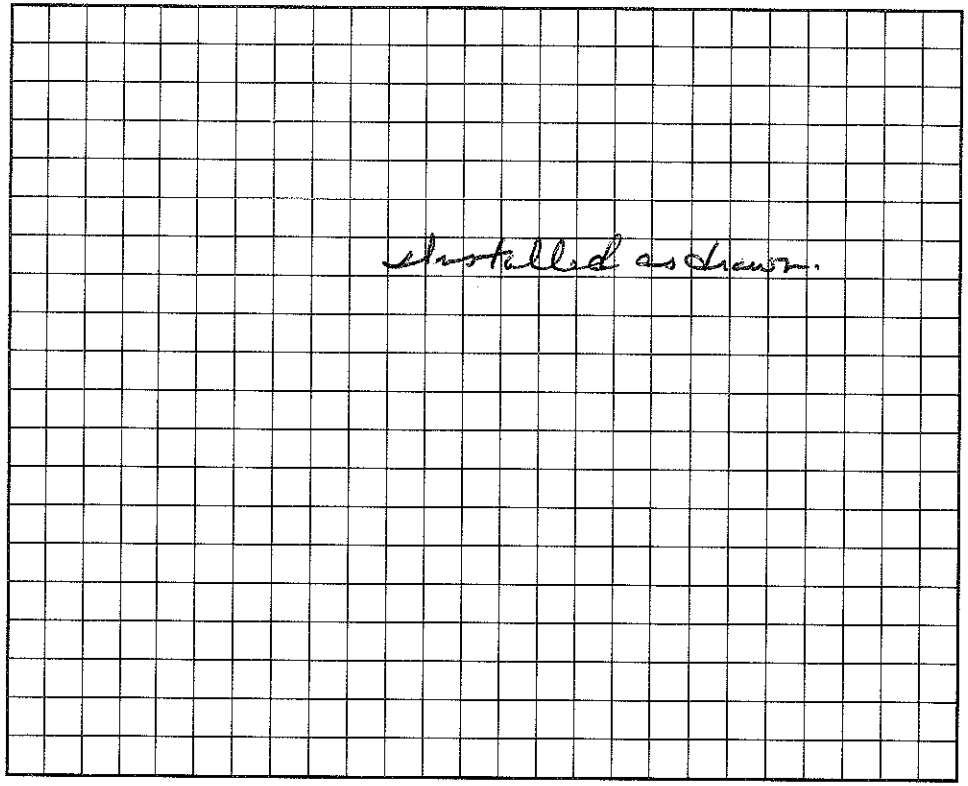

I understand that this permit can be suspended or revoked if any false information is supplied toward securing the permit/any unauthorized changes are made to the site/any unauthorized changes are made in the installation of the system. Improvement Permit is valid for 60 months from date of issuance.

Signed: James A Davidson

Improvement Permit by: Wesley Sparks RS. date 12/13/93

Existing System Inspection by: _____ date _____

Installed by: Tim Ammons

Certificate of Completion by: Wesley Sparks RS. date 4/21/94

Operation Permit by: _____ date _____

HEALTH DEPT. COPY: WHITE INSPECTION COPY (FINAL): GREEN OWNER COPY (FINAL): YELLOW INSPECTION COPY (INITIAL): PINK OWNER COPY (INITIAL): GOLD