213

IREDELL COUNTY HEALTH DEPARTMENT

STATESVILLE 704-878-5305 MOORESVILLE 704-664-5281

IMPROVEMENT PERMIT / AUTHORIZATION TO CONSTRUCT / OPERATION PERMIT / EXISTING SYSTEM INSPECTION

PERMIT# 072142 PIN# 4639 73 4530 (pt) 4638 86 8286 DATE May 1, 98

OWNER OR CONTRACTOR Stumpy Creek LLC // Carlo McCoy PHONE: Business 633-6124 Home

ADDRESS 614 N. Main Salisbury

LOCATION Perth Rd. N. TR Sagemore ON left

SUBDIVISION Harbor Landing BLOCK / SECTION II LOT 27 LOT AREA 25,841 ft² SITE CLASS PS DESIGN FLOW 360gpd L.T.A.R. .35

Septic Tank: 1000 Gallons; STB 794 Date 5-26-00
Pump Tank: 1000 Gallons; PT 283 Date 4-30-00
Pump Make: Myers Model ME30 Serial No. 3111P
Nitrification Field: No. Fields 1 Square Feet 1080 Linear Feet 360
No. Lines 3 @ 120' Trench Width 36" Max Trench Bottom Depth ~24"

☑ New System ☐ Repair System Type: I, II, (III), IV, V, VI
System Description: pumped-pw - MOD 25% Red.
Repair System Description: same
Maintenance Agreement Required: ☐ Yes ☑ No
Gravel Depth NA


☑ House/Mod. Home No. Bedrooms 3
☐ Mobile Home No. Bathrooms 2
☐ Business No. Employees
☐ Other
☐ Slab ☑ Crawl Space ☐ Basement w/plumbing ☐ Basement wo/plumbing

Water Supply: ☐ Individual ☐ Public ☑ Community


Comments:/Conditions: * ONE INSPECTION/OBSERVATION PORT PER LATERAL
Remove old Burns / TERRACES
5-24-00 Reviewed house & site plan; appears substantially in compliance w/ I.P.

Comments:/Conditions:
Label Filter Installed & Riser
R&H Tanks & lines Checked. 12/1/2000

INITIAL SITE SKETCH

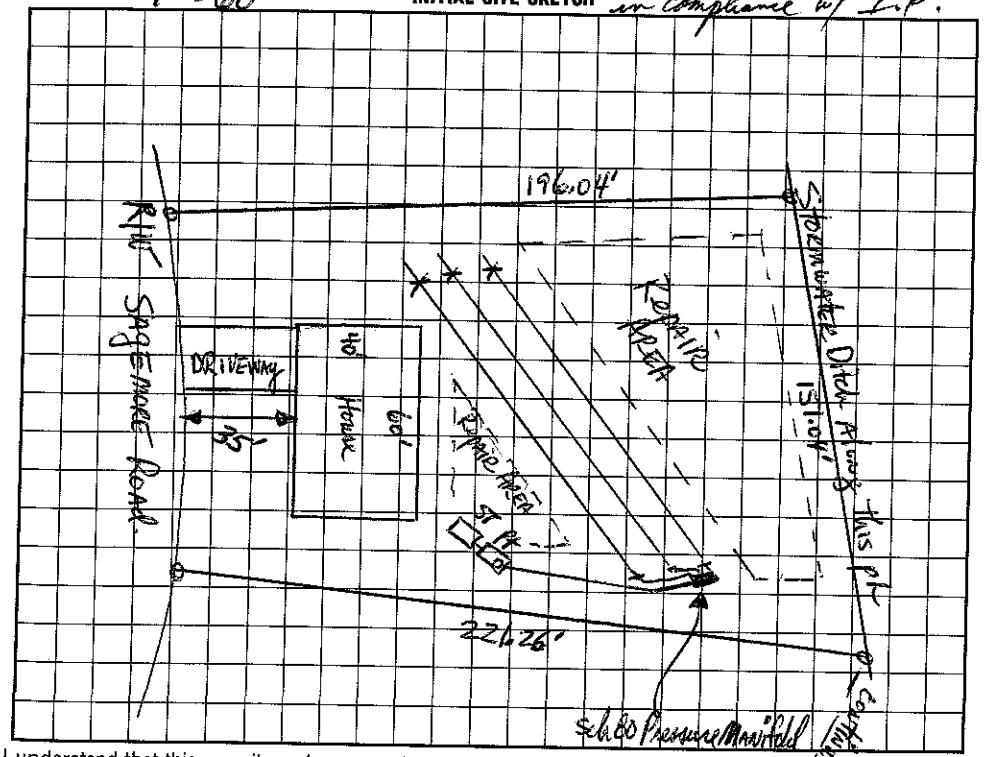

AS BUILT SKETCH

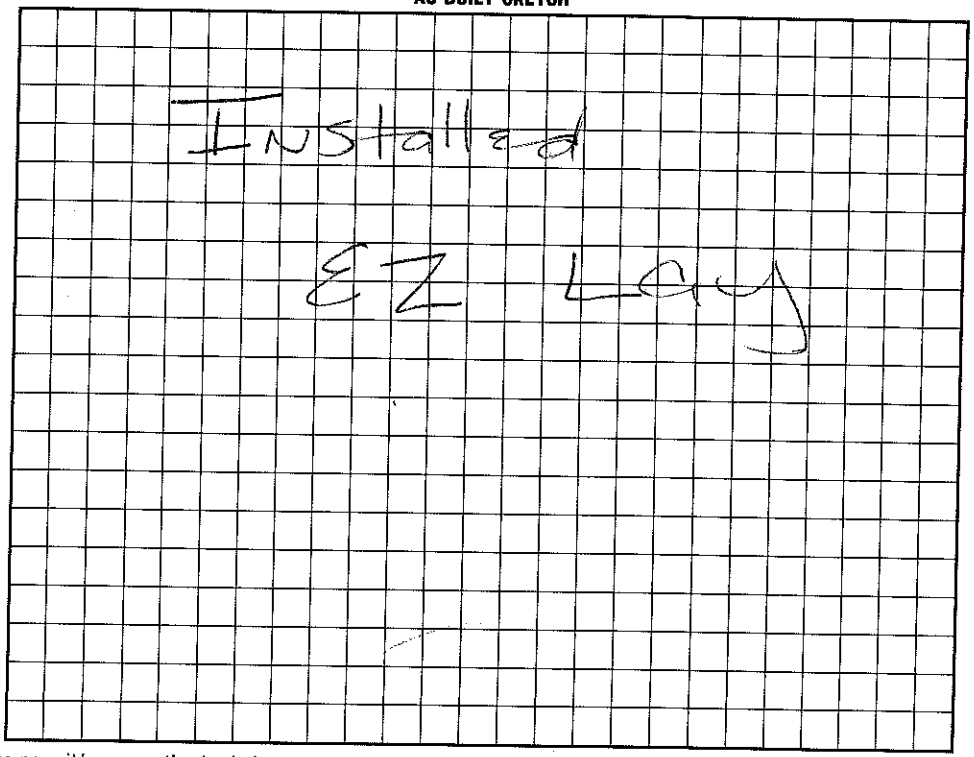

I understand that this permit can be suspended or revoked if any false information is supplied toward securing the permit/any unauthorized changes are made to the site/any unauthorized changes are made in the installation of the system. Improvement Permit with plat valid without expiration. Improvement Permit with site plan valid for sixty months. Authorization to Construct is valid for a period equal to that of Improvement Permit – not to exceed sixty months.

Signed: date 5/5/98 Installed by: R&H Inc

Improvement Permit by: date 5-1-98 Operation Permit by: date 12/6/2000

Authorization to Construct by: date 5-24-00 Existing System Inspection by: date

HEALTH DEPT. COPY: WHITE INSPECTION COPY (FINAL): GREEN OWNER COPY (FINAL): YELLOW INSPECTION COPY (INITIAL): PINK OWNER COPY (INITIAL): GOLD