IREDELL COUNTY HEALTH DEPARTMENT

STATESVILLE 704-878-5305 MOORESVILLE 704-664-5281

IMPROVEMENT PERMIT / AUTHORIZATION TO CONSTRUCT / OPERATION PERMIT / EXISTING SYSTEM INSPECTION

PERMIT # 15918 PIN # 4638-86-8581 DATE 1-28-10

OWNER or APPLICANT GLADYS HAGE PHONE: Business 704-201-9962 Home: LIGHTHOUSE GC INC.

OWNER or APPLICANT ADDRESS 119 HARBOR LANDING DR MOORESVILLE NC 28117

LOCATION / DIRECTIONS PERTH, TL ERNIE, TR HARBOR LANDING, ON R

SUBDIVISION HARBOR LANDING BLOCK / SECTION LOT # 32 LOT AREA .63 AC DESIGN FLOW 360 GPD L.T.A.R.

Septic Tank EXISTING Gallons: STB Date

Pump Tank Gallons: P T Date

Pump Make Model Serial #

Nitrification Field No Fields X No Lines Linear Feet

Trench Width EXISTING Max. Trench Bottom Depth Gravel Depth

☐ New System ☐ Repair ☐ Expansion System Type I (II) III IV V VI

System Description: GRAVITY 25% RED

Repair System Description: SAME

Maintenance Agreement Required ☐ YES ☒ NO

☒ GRAVITY ☐ PRESSURE

☒ Residence No. Bedrooms 3

☐ Business No. Persons

☐ Other No. Employees

☐ Slab ☒ Crawl Space

☐ Basement w/plumbing ☐ Basement w/o plumbing


Water Supply: ☒ Private ☐ Public ☐ Community

Comments / Conditions 1) ADDITION MUST BE MIN 5' FROM SEPTIC SYSTEM 2) SYSTEM LOOKS GOOD @ TIME OF INSPECTION

Comments / Conditions ADDITION SUN ROOM

INITIAL SITE SKETCH

AS BUILT SKETCH

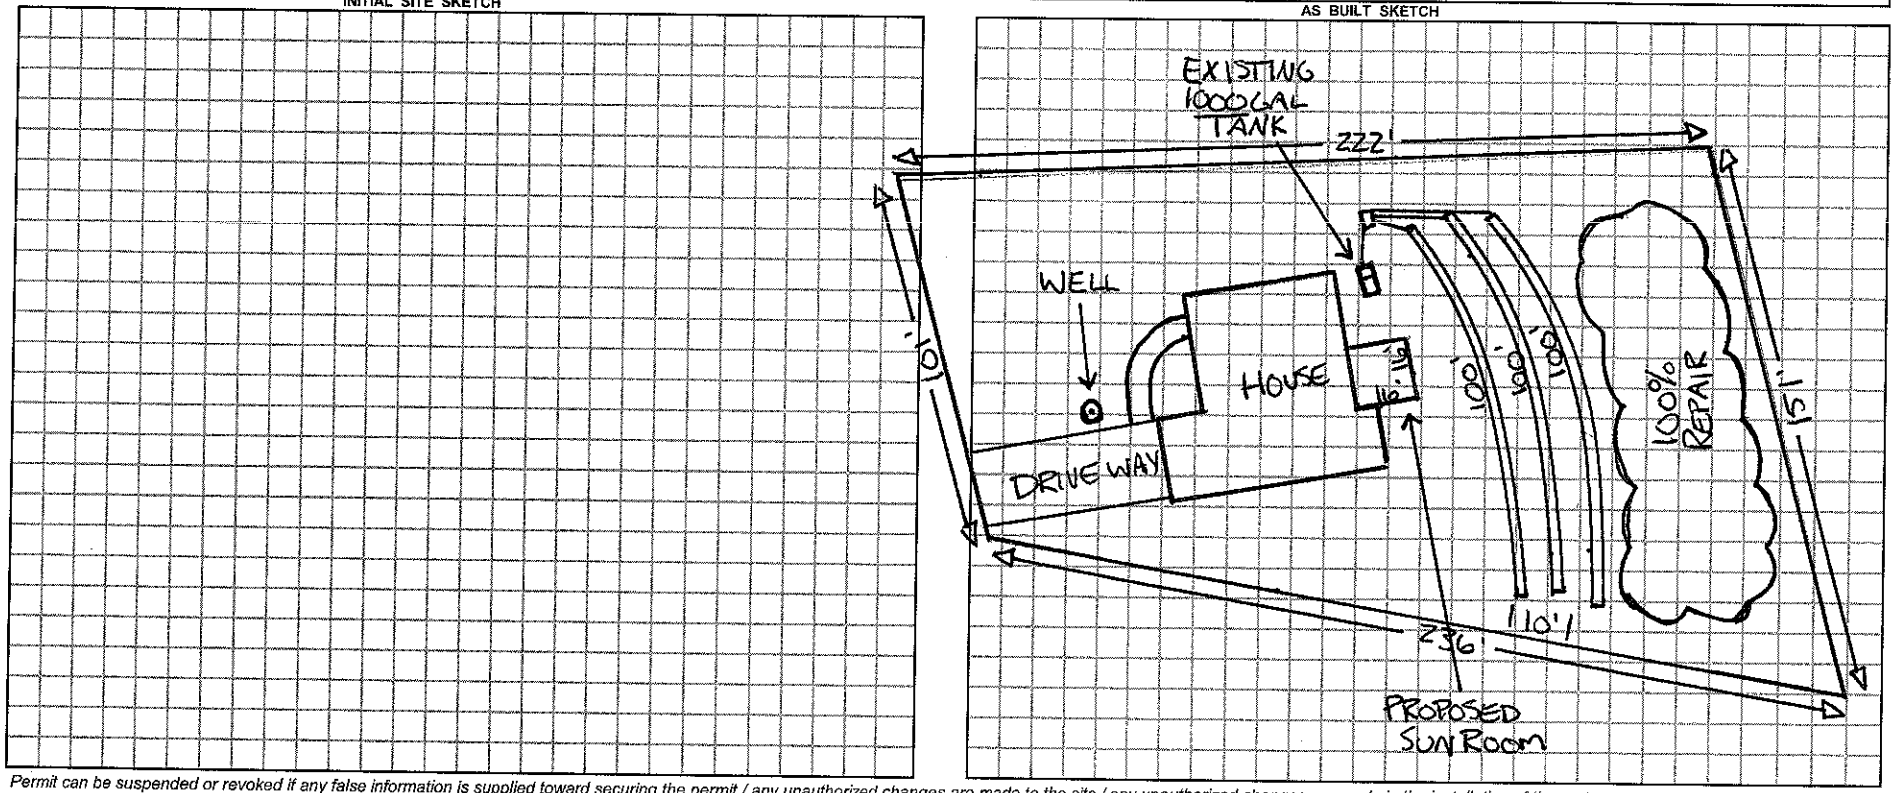

Permit can be suspended or revoked if any false information is supplied toward securing the permit / any unauthorized changes are made to the site / any unauthorized changes are made in the installation of the system.

☐ *IMPROVEMENT PERMIT w / plat valid without expiration.* ☐ *IMPROVEMENT PERMIT w / site plan valid for 60 mos.* ☐ *AUTHORIZATION TO CONSTRUCT valid for period equal to IMPROVEMENT PERMIT-not to exceed 60 mo.*

Owner / Applicant Signature: Gladys Todd Hage Date 1-28-10

Improvement Permit by: Date

Authorization to Construct by: Date

YOU SHOULD CONTACT A LOCATOR SERVICE PRIOR TO ANY EXCAVATION.

Installed by:

Operation Permit by: Date:

Existing System Inspected by: J. Allen REHS Date: 1-28-10

WHITE COPY Environmental Health YELLOW COPY (Final) Owner / Applicant PINK COPY (Initial) Owner / Applicant