2:00

IREDELL COUNTY HEALTH DEPARTMENT

STATESVILLE 704-878-5305 MOORESVILLE 704-664-5281

IMPROVEMENT PERMIT / AUTHORIZATION TO CONSTRUCT / OPERATION PERMIT / EXISTING SYSTEM INSPECTION

PERMIT# 72619 PIN# 4639734550 DATE 7/28/99

OWNER OR CONTRACTOR STUMPY CREEK LLC / CARROL FISHER CONST. PHONE: Business 633-6124 Home

ADDRESS 614 N MAIN SALISBURY / NC 28144

LOCATION PERTH RD - N - TR HARBOR LANDING - BEAR RT - ON LT

SUBDIVISION HARBOR LANDING BLOCK / SECTION III LOT 58 LOT AREA 25,091 ft2 SITE CLASS. PS DESIGN FLOW 360 gpd L.T.A.R. .25

Septic Tank: 1000 Gallons; STB 523 Date 6/11/99
Pump Tank: 1000 Gallons; PT 302 Date 6/11/99
Pump Make: Model Serial No.
Nitrification Field: No Fields 1 Square Feet 600 Linear Feet 300
No Lines 6@60' Trench Width 36" Max Trench Bottom Depth (30") Gravel Depth N/A

☑ New System ☐ Repair System Type: I, II, (III), IV, V, VI
System Description: PUMP 25% REDUCTION
Repair System Description: LP PANEL BLOCK
Maintenance Agreement Required: ☐ Yes ☑ No


☑ House/Mod. Home No. Bedrooms 3
☐ Mobile Home No. Bathrooms 2
☐ Business No. Employees
☐ Other
☐ Slab ☑ Crawl Space ☐ Basement w/plumbing ☐ Basement wo/plumbing

Water Supply: ☐ Individual ☐ Public ☑ Community


Comments:/Conditions:

Comments:/Conditions: (4@90')

INITIAL SITE SKETCH

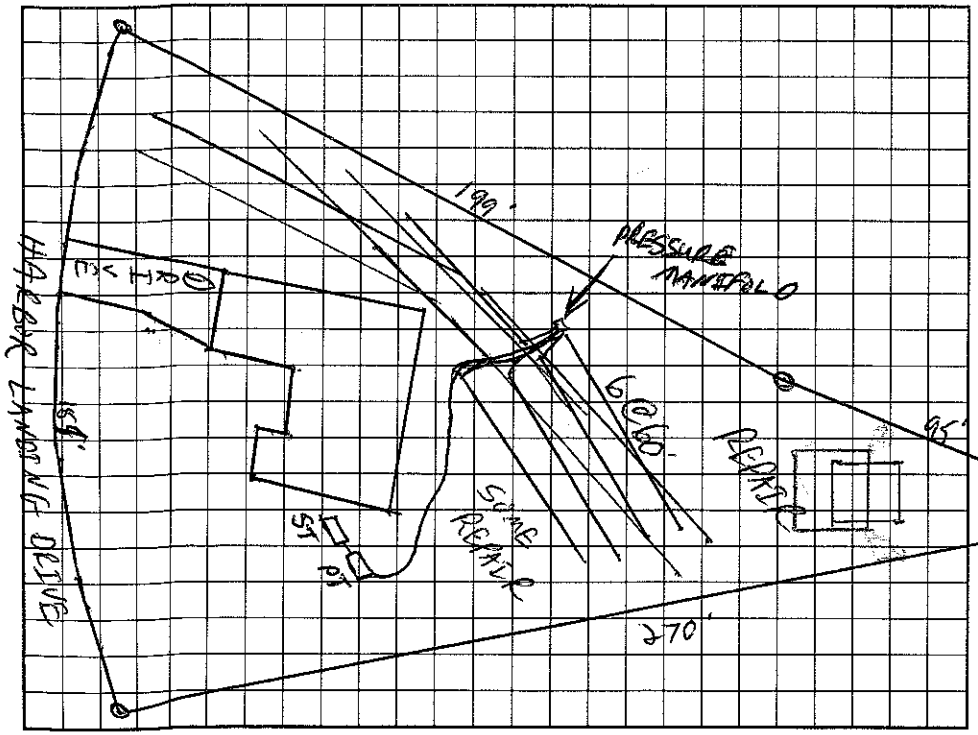

AS BUILT SKETCH

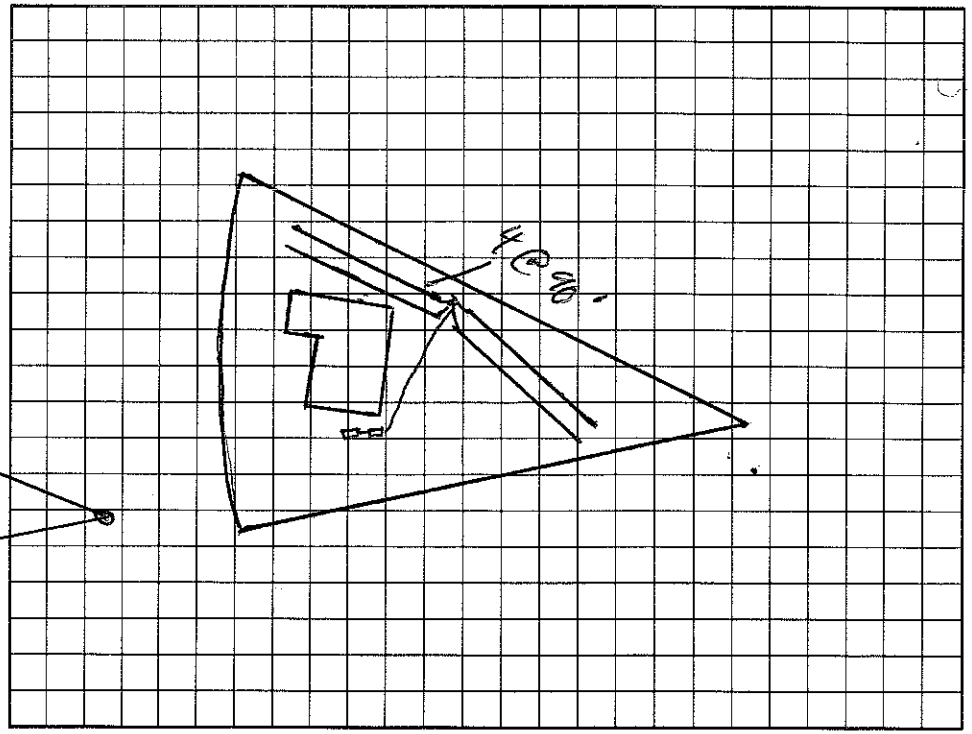

Permit can be suspended or revoked if any false information is supplied toward securing the permit/any unauthorized changes are made to the site/any unauthorized changes are made in the installation of the system. Improvement Permit with plat valid without expiration. Improvement Permit with site plan valid for sixty months. Authorization to Construct is valid for a period equal to that of Improvement Permit – not to exceed sixty months.

Signed: date 7/30/99 Installed by: ROWAN SEPTIC

Improvement Permit by: RS date 7/28/99 Operation Permit by: date

Authorization to Construct by: RS date 7/28/99 Existing System Inspection by: date

HEALTH DEPT. COPY: WHITE OWNER COPY (FINAL): YELLOW OWNER COPY (INITIAL): PINK