(4517 - code) 50.00 Paid 480

IREDELL COUNTY HEALTH DEPARTMENT

STATESVILLE 704-878-5305 MOORESVILLE 704-664-5281

IMPROVEMENT PERMIT / AUTHORIZATION TO CONSTRUCT / OPERATION PERMIT / EXISTING SYSTEM INSPECTION

PERMIT# 072141 PIN# 4639 73 4550 pt, 4638 86 9198 361-6865 DATE 11/1/01

OWNER OR CONTRACTOR Dan Custom Homes PHONE: Business 704-597-1461 Home

ADDRESS 4516 New Jordan Ct. Charlotte, NC. 28215

LOCATION 150 IN TR Perth TR Sagemore, 2, 3, and 5 lots on (L) 123 Sagemore Rd

SUBDIVISION HARBOR LANDING BLOCK / SECTION 2 LOT 26 LOT AREA ~22653 FT² SITE CLASS. PS DESIGN FLOW 480 L.T.A.R. .3

Septic Tank: 1000 Gallons; STB 825 Date 10/2/01
Pump Tank: 1000 Gallons; PT 302 ACS Date 10/8/01 ACS
Pump Make: ZOELLER Model 1680 Serial No. 560
Nitrification Field: No Fields 1 Square Feet ~~1250~~ Linear Feet ~~[redacted]~~
No Lines ~~[redacted]~~ Trench Width 3' Max Trench Bottom Depth 3' Gravel Depth 12"

☒ New System ☐ Repair System Type: I, II, (III) IV, V, VI
System Description: PM → CONVENTIONAL
Repair System Description: SAME
Maintenance Agreement Required: ☐ Yes ☒ No

☒ House/Mod. Home No. Bedrooms 4
☐ Mobile Home No. Bathrooms 4
☐ Business No. Employees
☐ Other
☐ Slab ☒ Crawl Space ☐ Basement w/plumbing ☐ Basement wo/plumbing


Water Supply: ☐ Individual ☐ Public ☑ Community

Comments: (8@70') N163 – 2/22/01


Comments/Conditions: Needs rope on pump, Rowan septic will supply rope on 12/7/01

(1" = 100')

INITIAL SITE SKETCH

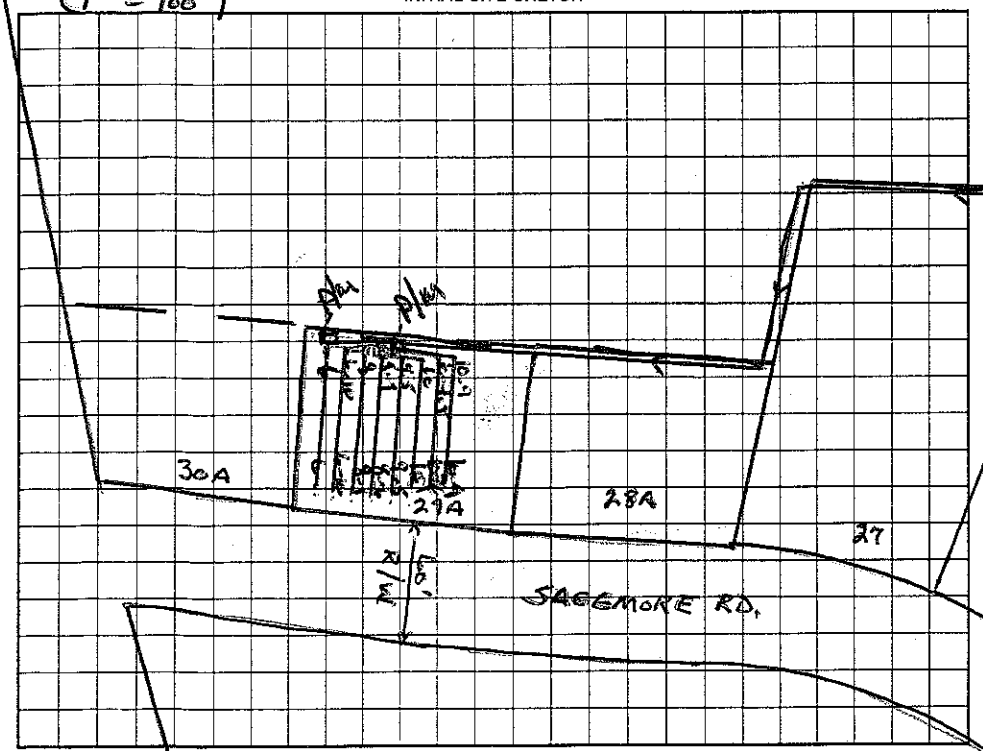

AS BUILT SKETCH

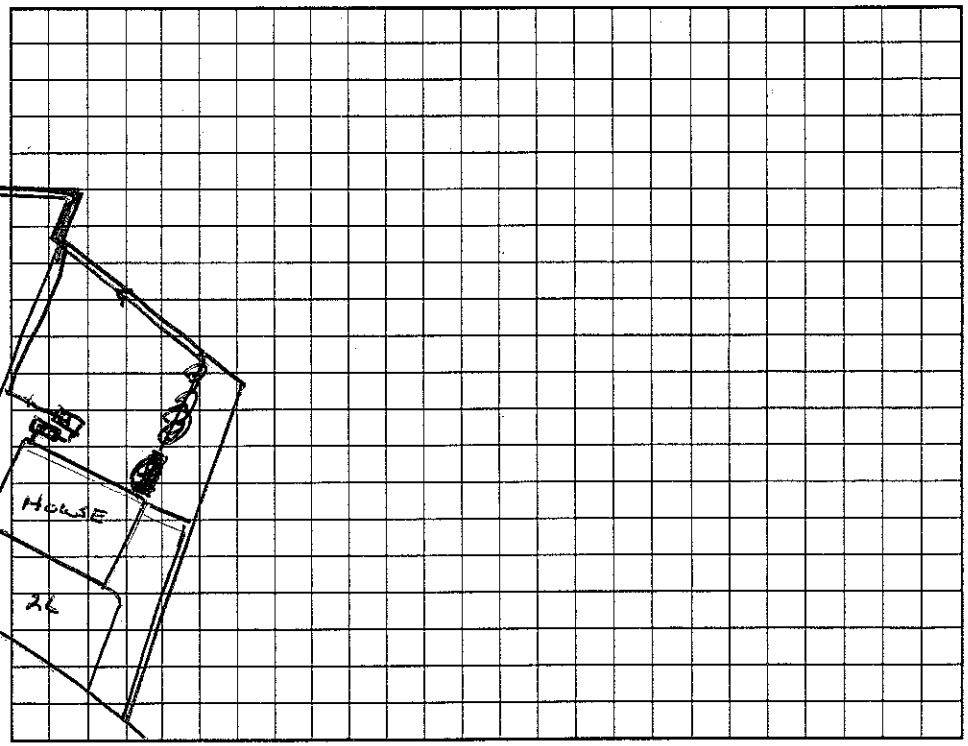

Permit can be suspended or revoked if any false information is supplied toward securing the permit/any unauthorized changes are made to the site/any unauthorized changes are made in the installation of the system. Improvement Permit with plat valid without expiration. Improvement Permit with site plan valid for sixty months. Authorization to Construct is valid for a period equal to that of Improvement Permit – not to exceed sixty months.

Signed: [illegible] date

Improvement Permit by: Wesley Sparks RS. date 11/1/01

Authorization to Construct by: Wesley Sparks RS. date 11/1/01

Installed by: Rowan Septic Tank RS

Operation Permit by: Maria H. Dobson date 12/7/01

Existing System Inspection by: date

HEALTH DEPT. COPY: WHITE OWNER COPY (FINAL): YELLOW OWNER COPY (INITIAL): PINK