3130

IREDELL COUNTY HEALTH DEPARTMENT

STATESVILLE 704-878-5305 MOORESVILLE 704-664-5281

IMPROVEMENT PERMIT / AUTHORIZATION TO CONSTRUCT / OPERATION PERMIT / EXISTING SYSTEM INSPECTION

PERMIT# 092581 PIN# ~~4639-93-4550 (pt)~~ 4638-86-9486 DATE July 6, 98

OWNER OR CONTRACTOR Stumpy Creek LLC PHONE: Business 633-6127 Home

ADDRESS 614 N. Main St Salisbury 28144

LOCATION Perth Rd. N. TR Sagamore TR Harbor Landing on left

SUBDIVISION Harbor Landing BLOCK / SECTION III LOT 31 LOT AREA 27626 ft² SITE CLASS PS DESIGN FLOW 360 gpd L.T.A.R. .3

Septic Tank: 1000 Gallons; STB 825 Date 6/21/99
Pump Tank: Gallons; PT Date
Pump Make: Model Serial No.
Nitrification Field: No Fields 1 Square Feet 900 Linear Feet 300
No Lines 5@60' Trench Width 36" Max Trench Bottom Depth 24" Gravel Depth NA

☑ New System ☐ Repair System Type: I, II, III, IV, V, VI
System Description: Gravity 25% Reduction
Repair System Description: SAME
Maintenance Agreement Required: ☐ Yes ☑ No

☑ House/Mod. Home No. Bedrooms 3
☐ Mobile Home No. Bathrooms 2
☐ Business No. Employees
☐ Other

☐ Slab ☑ Crawl Space ☐ Basement w/plumbing ☐ Basement wo/plumbing


Water Supply:
☐ Individual
☑ Public
☑ Community

Comments:/Conditions: * ONE INSPECTION/OBSERVATION PER TYPE PER CONTRACT.
REMOVE ANY OLD BURNS / TERRACES

Comments:/Conditions:
5-14-99 Contacted by Danny Fisher. He said it was his intention to build exactly as shown on I.P.

1"=60'

INITIAL SITE SKETCH

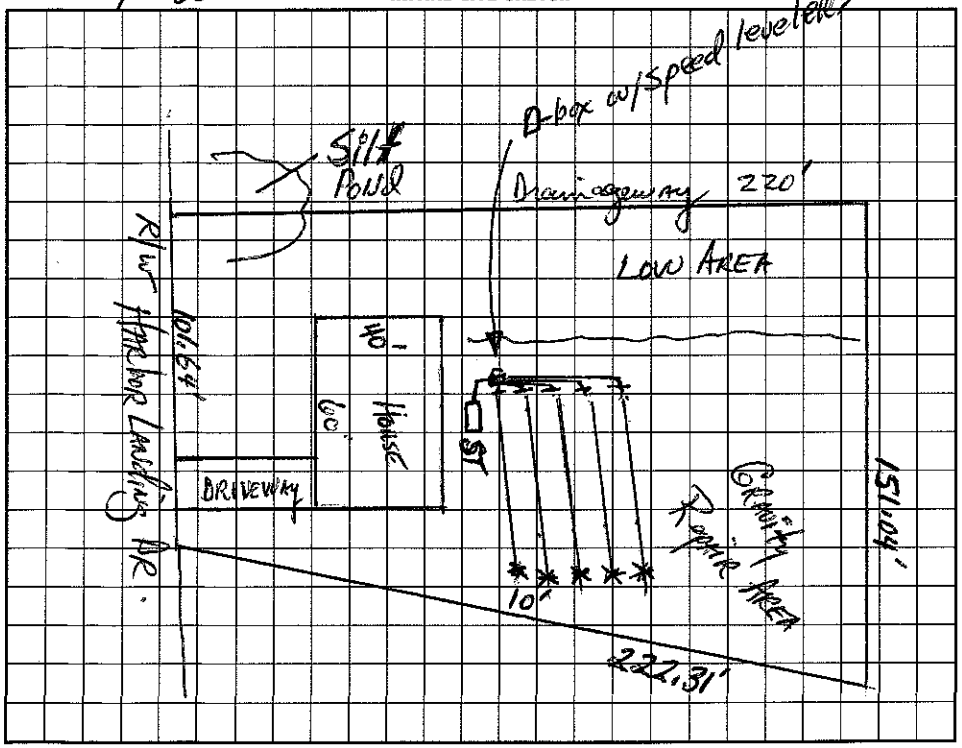

AS BUILT SKETCH

I understand that this permit can be suspended or revoked if any false information is supplied toward securing the permit/any unauthorized changes are made to the site/any unauthorized changes are made in the installation of the system. Improvement Permit with plat valid without expiration. Improvement Permit with site plan valid for sixty months. Authorization to Construct is valid for a period equal to that of Improvement Permit – not to exceed sixty months.

Signed: X date

Improvement Permit by: [signature] date 7-6-98

Authorization to Construct by: [signature] date 5-14-99

Installed by: Rowan Septic

Operation Permit by: Jeff Mason date 8/25/99

Existing System Inspection by: date

HEALTH DEPT. COPY: WHITE INSPECTION COPY (FINAL): GREEN OWNER COPY (FINAL): YELLOW INSPECTION COPY (INITIAL): PINK OWNER COPY (INITIAL): GOLD