IREDELL COUNTY HEALTH DEPARTMENT

STATESVILLE 704-878-5305 MOORESVILLE 704-664-5281

IMPROVEMENT PERMIT / AUTHORIZATION TO CONSTRUCT / OPERATION PERMIT / EXISTING SYSTEM INSPECTION

PERMIT# 072620 PIN# ~~4639-73-4550 (pt)~~ 4638-86-9734 DATE July 31, '98

OWNER OR CONTRACTOR Stumpy Creek LLC PHONE: Business 633-6124 Home

ADDRESS 614 N. Main / Salisbury, N.C. 28144

LOCATION Perth Rd N. TR into Harbor Landing Bear Right on left before jct w/ Sagamore

SUBDIVISION Harbor Landing BLOCK / SECTION III LOT 59 LOT AREA 28,410 ft² SITE CLASS PS / DESIGN FLOW 480gpd L.T.A.R. .25

Septic Tank: 1000 Gallons; STB 312 Date 4-12-99

Pump Tank: Gallons; PT Date

Pump Make: Model Serial No.

Nitrification Field: No Fields 1 Square Feet 1440 Linear Feet 480

No Lines 4@110-125 Trench Width 36" Max Trench Bottom Depth 30" Gravel Depth NA

☑ New System ☐ Repair System Type: I II III IV, V Conventional

System Description: Gravity @ 25% Reduction

Repair System Description: GRAV/Pumped 25% Red.

Maintenance Agreement Required: ☐ Yes ☑ No

☑ House/Mod. Home ☐ Mobile Home ☐ Business ☐ Other

No. Bedrooms 4 3 No. Bathrooms 3 No. Employees


Water Supply: ☐ Individual ☐ Public ☑ Community

☐ Slab ☑ Crawl Space ☐ Basement w/plumbing ☐ Basement wo/plumbing


Comments:/Conditions: Remove old Burns / Terraces
* ONE Inspection / observation port per LATERAL.

Comments:/Conditions: 8/25/99 Reduced Number of bedrooms from 4 to 3, therefore 480Ft of Conventional Drainline ok. MD

INITIAL SITE SKETCH 1"=60'

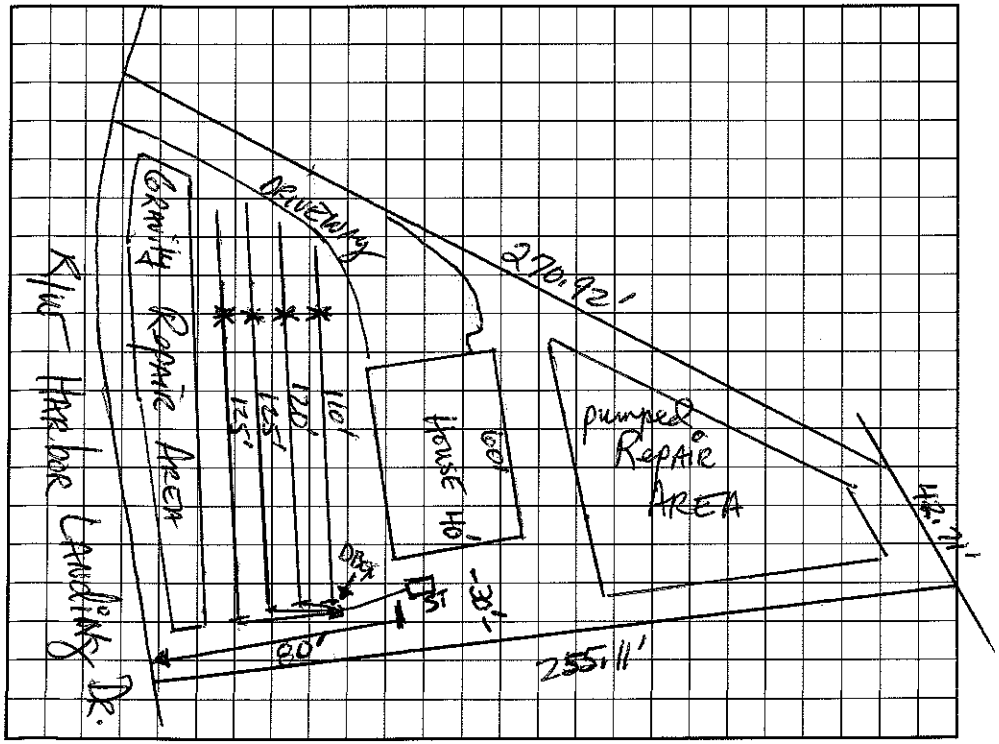

AS BUILT SKETCH

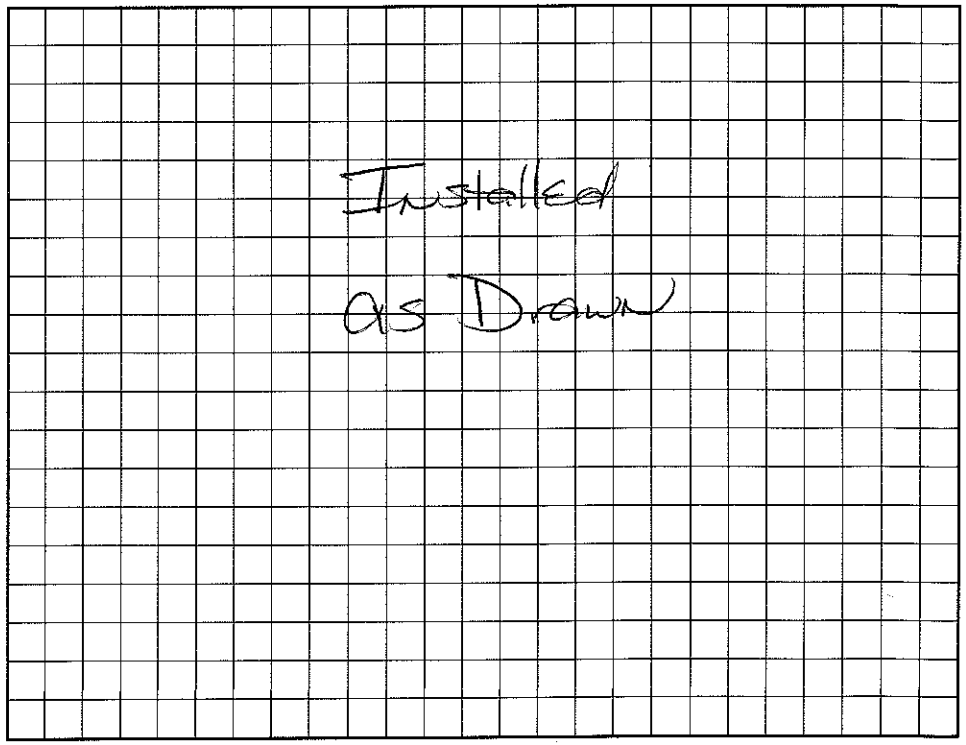

I understand that this permit can be suspended or revoked if any false information is supplied toward securing the permit/any unauthorized changes are made to the site/any unauthorized changes are made in the installation of the system. Improvement Permit with plat valid without expiration. Improvement Permit with site plan valid for sixty months. Authorization to Construct is valid for a period equal to that of Improvement Permit – not to exceed sixty months.

Signed: date

Improvement Permit by: date 7-31-98

Authorization to Construct by: date 10/22/98

Installed by: Larry Beam

Operation Permit by: Maria Dotson R.S. date 8/27/99

Existing System Inspection by: Maria Dotson R.S. date 8/27/99

HEALTH DEPT. COPY: WHITE INSPECTION COPY (FINAL): GREEN OWNER COPY (FINAL): YELLOW INSPECTION COPY (INITIAL): PINK OWNER COPY (INITIAL): GOLD