(3:00)(3:30)

IREDELL COUNTY HEALTH DEPARTMENT

STATESVILLE 704-878-5305 MOORESVILLE 704-664-5281

IMPROVEMENT PERMIT / CERTIFICATE OF COMPLETION / OPERATION PERMIT / EXISTING SYSTEM INSPECTION

PROPERTY DESCRIPTION NO. 066839 DATE July 31, '97 TAX MAP NO. ~~4638 79 1916~~ 4638-87-0464 Watershed: ☑ Yes ☐ No

OWNER OR CONTRACTOR Stampy Creek LLC PHONE: Business 6336124 Home

ADDRESS 614 N. Main Salisbury 28144

LOCATION Faith Rd. N. to Woodstock Cove 2nd lot on left 360 GPD

SUBDIVISION Harborview BLOCK / SECTION 5 LOT 17 LOT AREA .56 AC SITE CLASS PS DESIGN FLOW ~~400 gpd~~ L.T.A.R. .3

Septic Tank: 1000 Gallons; STB 825 Date 11/1/97

Pump Tank: ____ Gallons; PT ____ Date ____

Pump Make: ____ Model ____ Serial No. ____

Nitrification Field: No Fields 1 Square Feet 1200 Linear Feet 400

No Lines 5@80' Trench Width 36" Max Trench Bottom Depth ~30" Gravel Depth NA

☑ New System ☐ Repair System Type: I, II, ~~III~~, IV, V, VI

System Description: gravity chamber CONV.

Repair System Description: same

Maintenance Agreement Required: ☐ Yes ☑ No

☑ Slab ☐ Crawl Space ☐ Basement w/plumbing ☐ Basement wo/plumbing

☐ House/Mod. Home No. Bedrooms ~~3~~ 4

☐ Mobile Home No. Bathrooms 2.5

☐ Business No. Employees ____

☐ Other ____


Water Supply:
☐ Individual
☑ ~~Community~~
☐ Public

Comments: ONE INSPECTION PORT PER LATERAL

Comments: CONVENTIONAL SYSTEM - CHANGE IN # BEDROOMS
3BR

1" = 50'

INITIAL SITE SKETCH

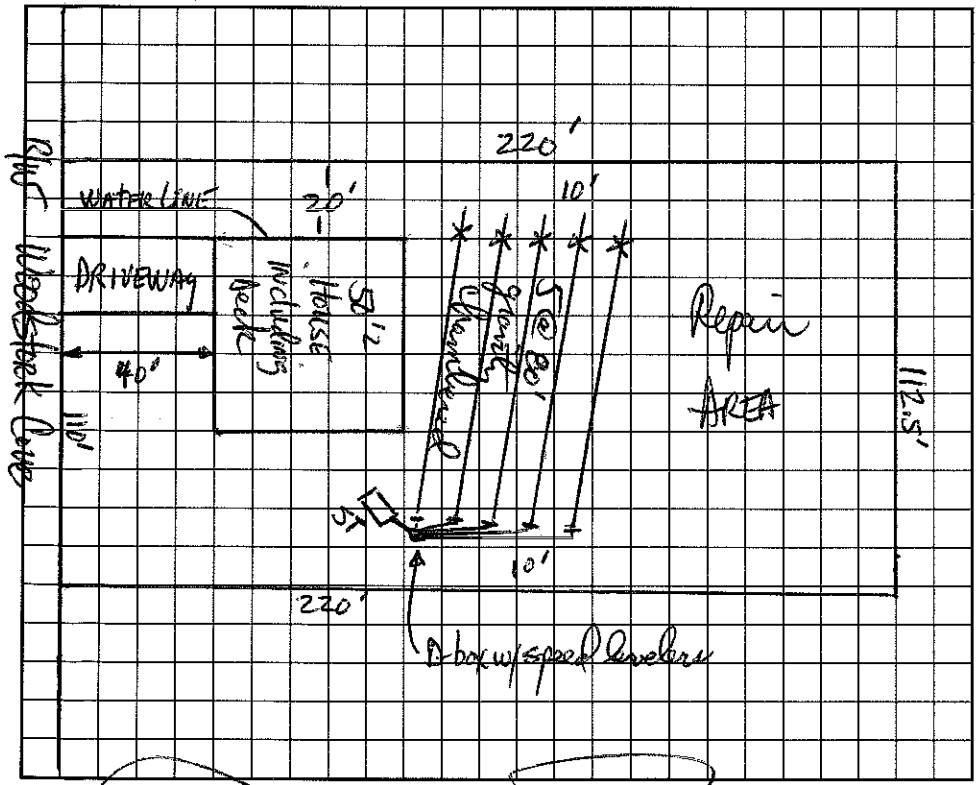

AS BUILT SKETCH

SAME AS SKETCH

I understand that this permit can be suspended or revoked if any false information is supplied toward securing the permit/any unauthorized changes are made to the site/any unauthorized changes are made in the installation of the system. Improvement Permit is valid for 60 months from date of issuance.

Signed: ____

Improvement Permit by: ____ date 7-31-97

~~Existing System Inspection by:~~ CONSTRUCTION ____ date 9/13/97

Although from

Installed by: ROWAN SEPTIC

Certificate of Completion by: ____ date ____

Operation Permit by: ____ date 10/29/97

HEALTH DEPT. COPY: WHITE INSPECTION COPY (FINAL): GREEN OWNER COPY (FINAL): YELLOW INSPECTION COPY (INITIAL): PINK OWNER COPY (INITIAL): GOLD