IREDELL COUNTY HEALTH DEPARTMENT Const. Auth. STATESVILLE 704-878-5305 MOORESVILLE 704-664-5281

IMPROVEMENT PERMIT / ~~CERTIFICATE OF COMPLETION~~ / OPERATION PERMIT / EXISTING SYSTEM INSPEC...N

PROPERTY DESCRIPTION NO. 066838 DATE July 31, '97 TAX MAP NO. 4638 77 1716 Watershed: ☑ Yes ☐ No

OWNER OR CONTRACTOR Stumpy Creek LLC / OGDEN C & NSJ PHONE: Business 633-6124 Home

ADDRESS 614 N. Main Salisbury 28144

LOCATION Perth Rd. N TL Woodstork Cove, immediately on left

SUBDIVISION Harborview BLOCK / SECTION 5 LOT 16 LOT AREA .57AC SITE CLASS. PS DESIGN FLOW 360gpd L.T.A.R. .3

Septic Tank: 1000 Gallons; STB 1012 Date 10-07-00
Pump Tank: ____ Gallons; PT ____ Date ____
Pump Make: ____ Model ____ Serial No. ____
Nitrification Field: No Fields 1 Square Feet 900 Linear Feet 300
No Lines 5@60' Trench Width 36" Max Trench Bottom Depth ~30" Gravel Depth NA

☑ New System ☐ Repair System Type: I, II, (III) IV, V, VI
System Description: gravity chambered
Repair System Description: same
Maintenance Agreement Required: ☐ Yes ☑ No

☑ House/Mod. Home No. Bedrooms 3
☐ Mobile Home No. Bathrooms 2
☐ Business No. Employees ____
☐ Other ____
☑ Slab ☐ Crawl Space ☐ Basement w/plumbing ☐ Basement wo/plumbing


Water Supply:
☐ Individual
☑ Community
☐ Public

Comments:

Comments: Polylok filter installed & riser.

1"=50'

INITIAL SITE SKETCH

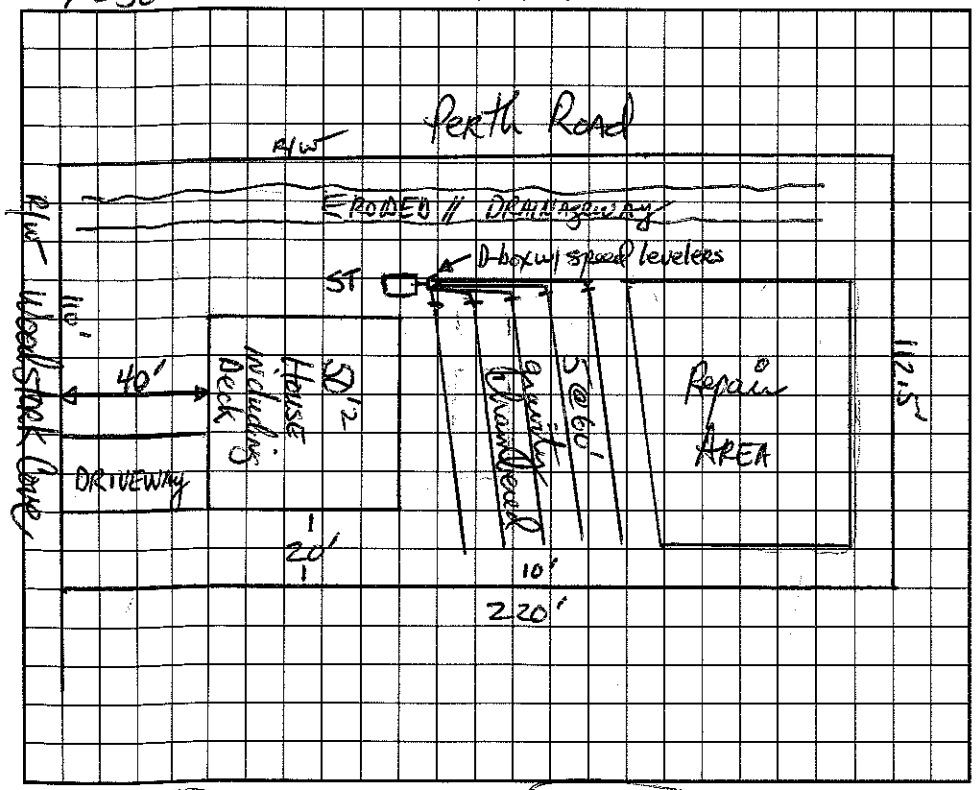

AS BUILT SKETCH

Installed as Drawn, Used "Plastic Chambers"

I understand that this permit can be suspended or revoked if any false information is supplied toward securing the permit/any unauthorized changes are made to the site/any unauthorized changes are made in the installation of the system. Improvement Permit is valid for 60 months from date of issuance.

Signed: ____

Improvement Permit by: DR Morgan RS date 7-31-97

~~Construction~~ ~~Existing System Inspection~~ by: C. Bryan RS date 1/18/01

Installed by: Richard Lee Nathan

Certificate of Completion by: Mark H. Dotson RS date 4/20/2001

Operation Permit by: Mark H. Dotson RS date 4/20/2001

HEALTH DEPT. COPY: WHITE INSPECTION COPY (FINAL): GREEN OWNER COPY (FINAL): YELLOW INSPECTION COPY (INITIAL): PINK OWNER COPY (INITIAL): GOLD