IREDELL COUNTY HEALTH DEPARTMENT

STATESVILLE 704-878-5305 MOORESVILLE 704-664-5281

IMPROVEMENT PERMIT / AUTHORIZATION TO CONSTRUCT / OPERATION PERMIT / EXISTING SYSTEM INSPECTION

PERMIT# 072603 PIN# 4639 73 4550 (pt) 4638 87 1885 DATE May 24 '99

OWNER OR CONTRACTOR Dennis Homes PHONE: Business 528-4270 ; 579-3000 Home

ADDRESS

LOCATION Perth Rd N. TR into Harbor Landing Bear left on left

SUBDIVISION Harbor Landing BLOCK / SECTION III LOT 45 LOT AREA 22,777 ft² SITE CLASS. PS DESIGN FLOW 360 gpd L.T.A.R. @ 3

Septic Tank: 1000 Gallons; STB [redacted] 794 Date 1/19/99

Pump Tank: 1000 Gallons; PT 27 Date 9/28/99

Pump Make: Hydromatic Model 5K50M1 Serial No. 8-99

Nitrification Field: No Fields 1 Square Feet 900 Linear Feet 300

No Lines 3 @ 100' Trench Width 36" Max Trench Bottom Depth 24" Gravel Depth NA

☑ New System ☐ Repair System Type: I, II, (III), IV, V, VI

System Description: PM- INNOVATIVE - 25% Reduction

Repair System Description: LP Panel Block

Maintenance Agreement Required: ☐ Yes ☑ No

☑ House/Mod. Home ☐ Mobile Home ☐ Business ☐ Other

No. Bedrooms 3 No. Bathrooms 3 No. Employees

☐ Slab ☑ Crawl Space ☐ Basement w/plumbing ☐ Basement wo/plumbing


Water Supply: ☐ Individual ☑ ~~Public~~ ☐ Community

Comments:/Conditions: * ONE inspection port PER LATERAL

Comments:/Conditions:

1" = 50'

INITIAL SITE SKETCH

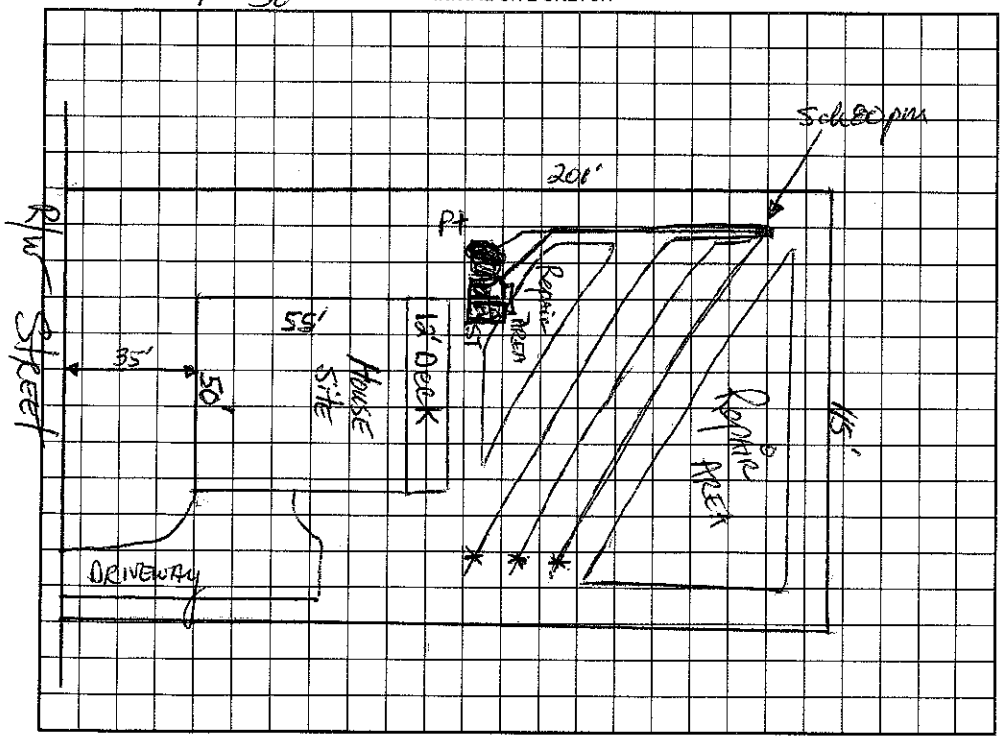

AS BUILT SKETCH

Permit can be suspended or revoked if any false information is supplied toward securing the permit/any unauthorized changes are made to the site/any unauthorized changes are made in the installation of the system. Improvement Permit with plat valid without expiration. Improvement Permit with site plan valid for sixty months. Authorization to Construct is valid for a period equal to that of Improvement Permit – not to exceed sixty months.

Signed: [signature] date 5-24-99 Installed by: Larry Beam

Improvement Permit by: [signature] RS date 5-24-99 Operation Permit by: Wesley Sparks RS. date 11/29/99

Authorization to Construct by: [signature] RS date 5-24-99 Existing System Inspection by: date

HEALTH DEPT. COPY: WHITE OWNER COPY (FINAL): YELLOW OWNER COPY (INITIAL): PINK