IREDELL COUNTY HEALTH DEPARTMENT

Const. Auth. STATESVILLE 704-878-5305 MOORESVILLE 704-664-5281

2102

IMPROVEMENT PERMIT / ~~CERTIFICATE OF COMPLETION~~ / OPERATION PERMIT / EXISTING SYSTEM INSPECTION

PROPERTY DESCRIPTION NO. 066837 DATE July 31, '97 TAX MAP NO. ~~4658-77-1776~~ 4638-87-2313 Watershed: ☑ Yes ☐ No

OWNER OR CONTRACTOR Stumpy Creek LLC / Ogden Constr PHONE: Business 6336124 Home

ADDRESS 614 N. Main Salisbury 28144

LOCATION Perth Road N. on left just past Whimbrell Ct.

SUBDIVISION Harborview BLOCK / SECTION 4 LOT 15 LOT AREA .62ac SITE CLASS. PS DESIGN FLOW 480gpd L.T.A.R. .3

Septic Tank: 1000 Gallons; STB 1012 Date 1-9-01

Pump Tank: ____ Gallons; PT ____ Date ____

Pump Make: ____ Model ____ Serial No. ____

Nitrification Field: No Fields 2 Square Feet 1200 Linear Feet 400

No Lines 3+3 Trench Width 36" Max Trench Bottom Depth ~30" Gravel Depth NA

☑ New System ☐ Repair System Type: I, II, (III), IV, V, VI

System Description: gravity chambered

Repair System Description: pumped chambered

Maintenance Agreement Required: ☐ Yes ☑ No

☑ House/Mod. Home No. Bedrooms 4

☐ Mobile Home No. Bathrooms 2.5

☐ Business No. Employees ____

☐ Other ____


☑ Slab ☐ Crawl Space ☐ Basement w/plumbing ☐ Basement wo/plumbing

Water Supply: ☐ Individual ☑ Community ☐ Public

Comments: 5-14-01 Reviewed floorplan - Right side load garage to be used - DH

Comments:

INITIAL SITE SKETCH 1" ≈ 40'

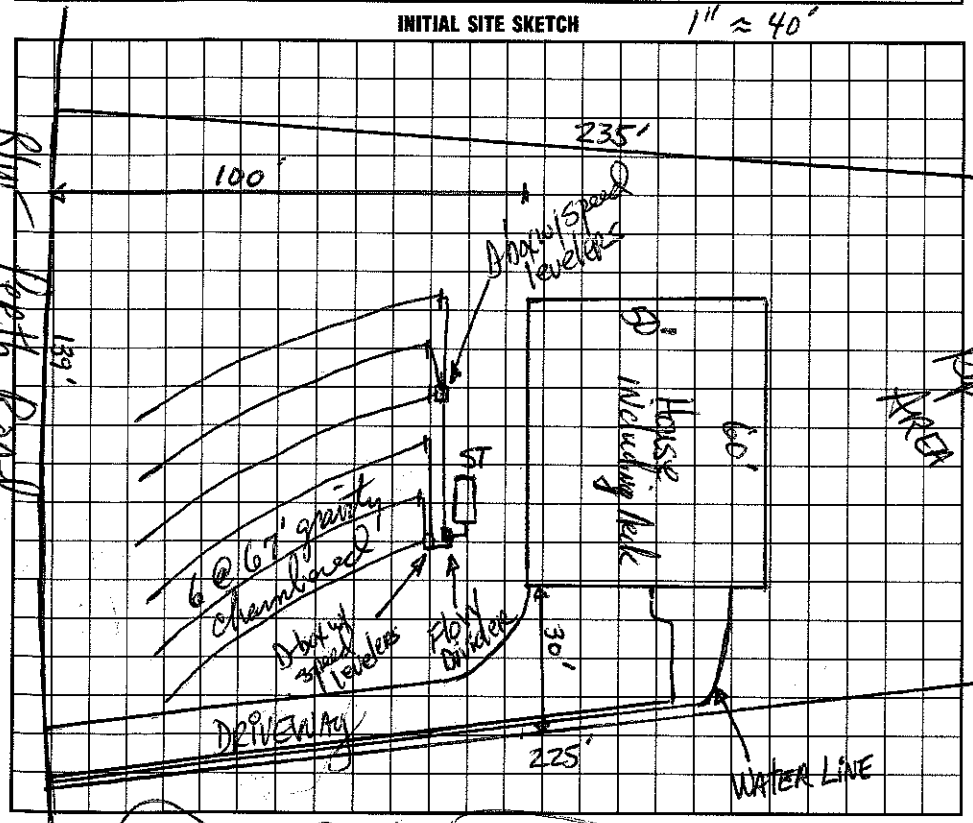

AS BUILT SKETCH

I understand that this permit can be suspended or revoked if any false information is supplied toward securing the permit/any unauthorized changes are made to the site/any unauthorized changes are made in the installation of the system. Improvement Permit is valid for 60 months from date of issuance.

Signed: ____

Improvement Permit by: ____ date 7-31-97

Construction ~~Existing system inspection by~~: ____ date 5-14-01

Authorized Agent

Installed by: Richard Abel

Certificate of Completion by: ____ date 8/14/01

Operation Permit by: ____ date ____

HEALTH DEPT. COPY: WHITE INSPECTION COPY (FINAL): GREEN OWNER COPY (FINAL): YELLOW INSPECTION COPY (INITIAL): PINK OWNER COPY (INITIAL): GOLD