IREDELL COUNTY HEALTH DEPARTMENT

STATESVILLE 704-878-5305 MOORESVILLE 704-664-5281

IMPROVEMENT PERMIT / AUTHORIZATION TO CONSTRUCT / OPERATION PERMIT / EXISTING SYSTEM INSPECTION

PERMIT# 072-602 PIN# 4639 73 4550 (pt) 4638 87 2766 DATE 10/12/98

OWNER OR CONTRACTOR STUMPY CREEK LLC PHONE: Business _____ Home 633-6124

ADDRESS 614 N. MAIN SALISBURY NC 28144

LOCATION PERTH RD TR HARBOR LANDING - REAR LT ON LT.

SUBDIVISION HARBOR LANDING BLOCK / SECTION III LOT 44 LOT AREA _____ SITE CLASS. PS DESIGN FLOW 360 gpd L.T.A.R. .39 gpd/ft²

Septic Tank: 1000 Gallons; STB 744 Date 2/17/99
Pump Tank: _____ Gallons; PT 27 Date 3/23/99
Pump Make: _____ Model _____ Serial No. _____
Nitrification Field: No Fields 1 Square Feet 900 Linear Feet 300
No Lines 3@100' Trench Width 36" Max Trench Bottom Depth 24" Gravel Depth N/A

☑ New System ☐ Repair System Type: I, II, III, IV, V, VI
System Description: PUMP CHAMBERS OR HDS
Repair System Description: SAME
Maintenance Agreement Required: ☐ Yes ☑ No


☑ House/Mod. Home No. Bedrooms 3
☐ Mobile Home No. Bathrooms 2
☐ Business No. Employees _____
☐ Other _____
☐ Slab ☑ Crawl Space ☐ Basement w/plumbing ☐ Basement wo/plumbing

Water Supply: ☐ Individual ☐ Public ☑ Community


Comments:/Conditions:

Comments:/Conditions:

INITIAL SITE SKETCH 1"=60'

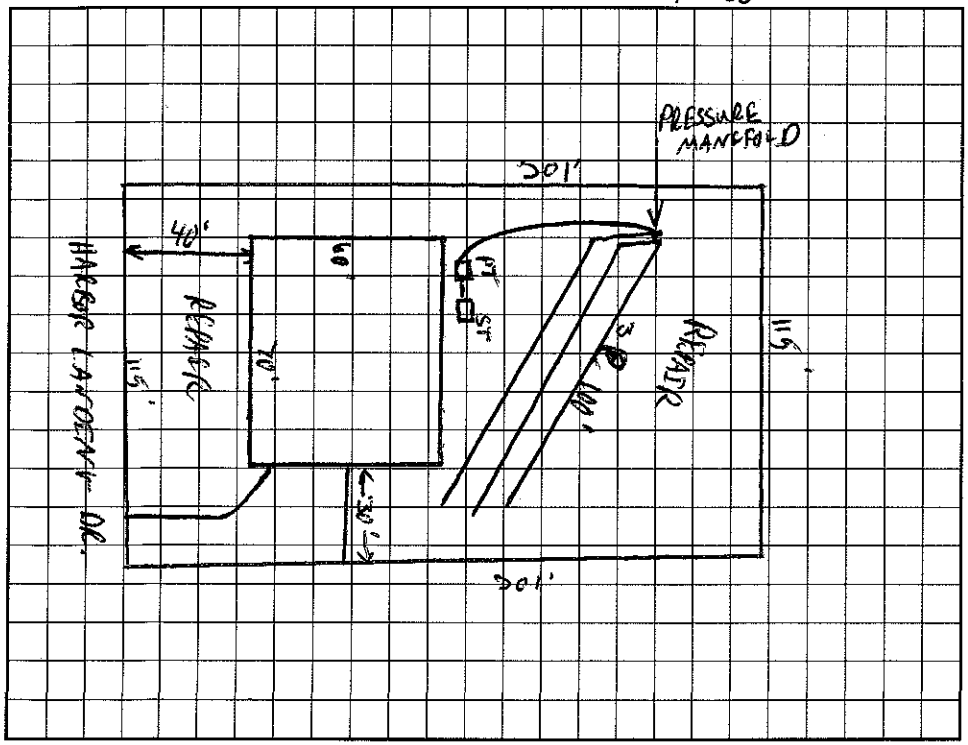

AS BUILT SKETCH

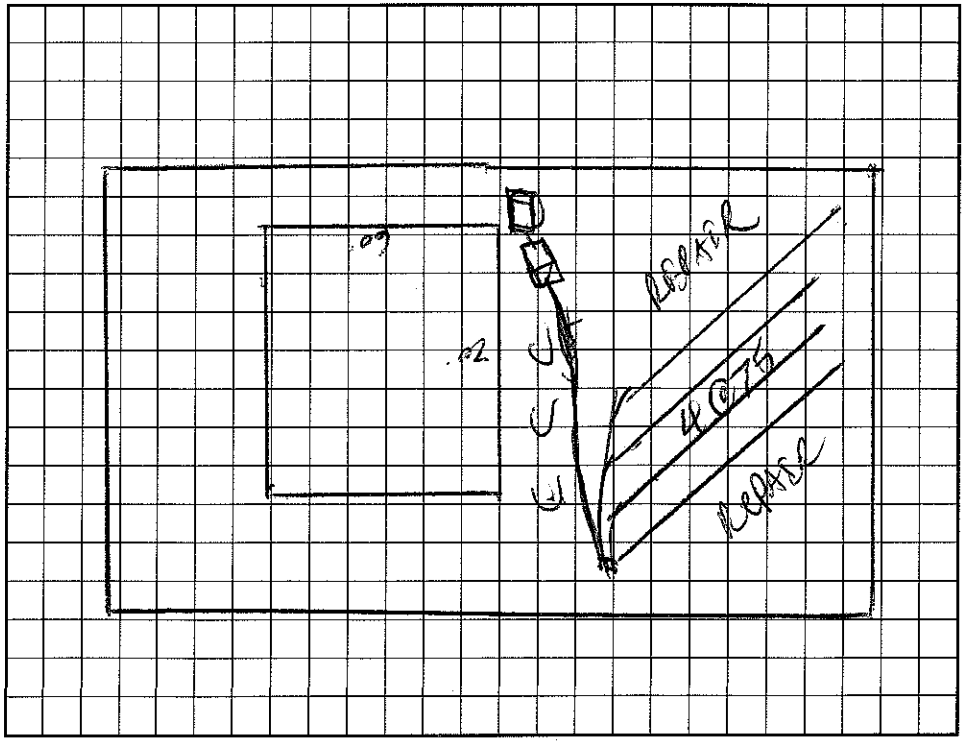

I understand that this permit can be suspended or revoked if any false information is supplied toward securing the permit/any unauthorized changes are made to the site/any unauthorized changes are made in the installation of the system. Improvement Permit with plat valid without expiration. Improvement Permit with site plan valid for sixty months. Authorization to Construct is valid for a period equal to that of Improvement Permit – not to exceed sixty months.

Signed: _____ date 10/12/98 Installed by: LARRY BEAM

Improvement Permit by: _____ RS date 10/12/98 Operation Permit by: _____ date 5/24/99

Authorization to Construct by: _____ RS date 10/12/98 Existing System Inspection by: _____ date _____

HEALTH DEPT. COPY: WHITE INSPECTION COPY (FINAL): GREEN OWNER COPY (FINAL): YELLOW INSPECTION COPY (INITIAL): PINK OWNER COPY (INITIAL): GOLD