IREDELL COUNTY HEALTH DEPARTMENT Const. Auth. STATESVILLE 704-878-5305 MOORESVILLE 704-664-5281 1:30

IMPROVEMENT PERMIT / ~~CERTIFICATE OF COMPLETION~~ / OPERATION PERMIT / EXISTING SYSTEM INSPECTION

PROPERTY DESCRIPTION NO. 066836 DATE July 31, 197 TAX MAP NO. ~~4638778178~~ 4638-87-3122 Watershed: ☑ Yes ☐ No

OWNER OR CONTRACTOR Stumpy Creek LLC / Dacen Construction PHONE: Business Home

ADDRESS 614 N. Main Salisbury 28144

LOCATION Perth Rd. N. to Whimbrell Ct. immediately on right

SUBDIVISION Harborview BLOCK / SECTION 4 LOT 14 LOT AREA .66Ac SITE CLASS. RS DESIGN FLOW 460gpd L.T.A.R. .3

Septic Tank: 1000 Gallons; STB 1012 Date

Pump Tank: Gallons; PT Date

Pump Make: Model Serial No.

Nitrification Field: No Fields 1 Square Feet 1200 Linear Feet 400

No Lines 5@80' Trench Width 36" Max Trench Bottom Depth ~30" Gravel Depth NA

☑ New System ☐ Repair System Type: I, II, III, IV, V, VI

System Description: gravity chamberge

Repair System Description: gravity pumped chamber

Maintenance Agreement Required: ☐ Yes ☒ No

☑ House/Mod. Home No. Bedrooms 4

☐ Mobile Home No. Bathrooms ~~3~~ 3.5

☐ Business No. Employees

☐ Other

☑ Slab ☐ Crawl Space ☐ Basement w/plumbing ☐ Basement wo/plumbing


Water Supply: ☐ Individual ☑ ~~Community~~ ☐ Public

Comments: 5-14-01 House & driveway to be constructed as shown on IP.


Comments: Checked tank & lines. 8/13/2001 MP Need to check D-box & check water line. OK 8-14-2001

1" = 40'

INITIAL SITE SKETCH

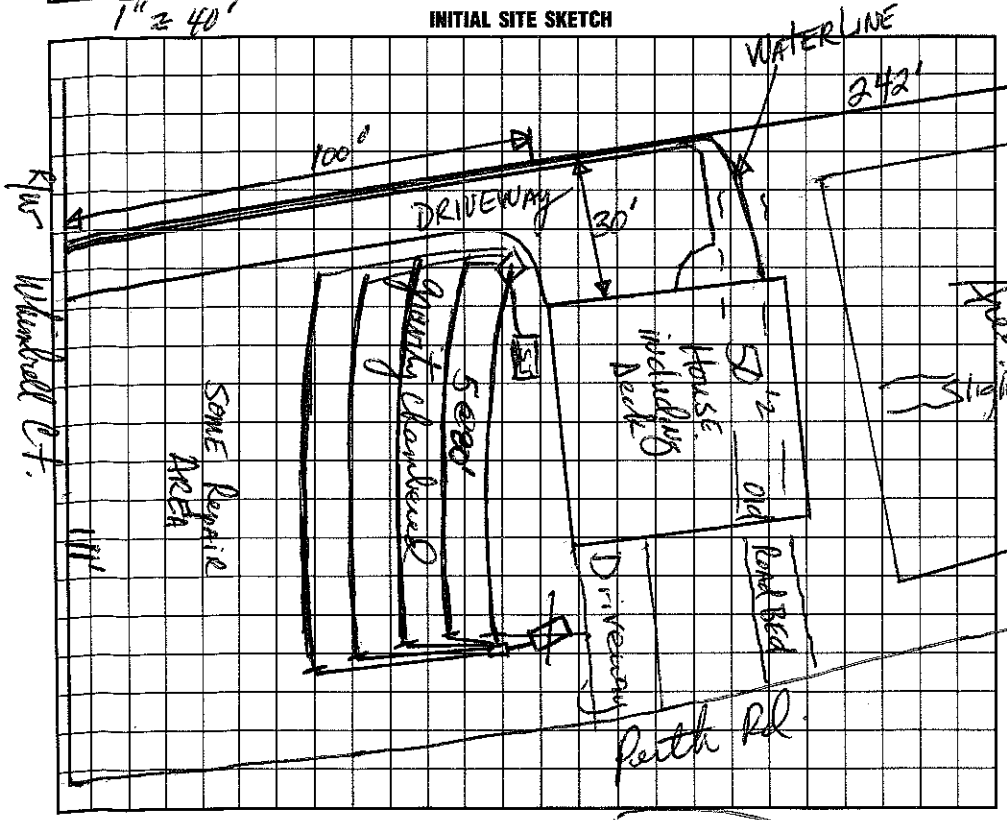

AS BUILT SKETCH

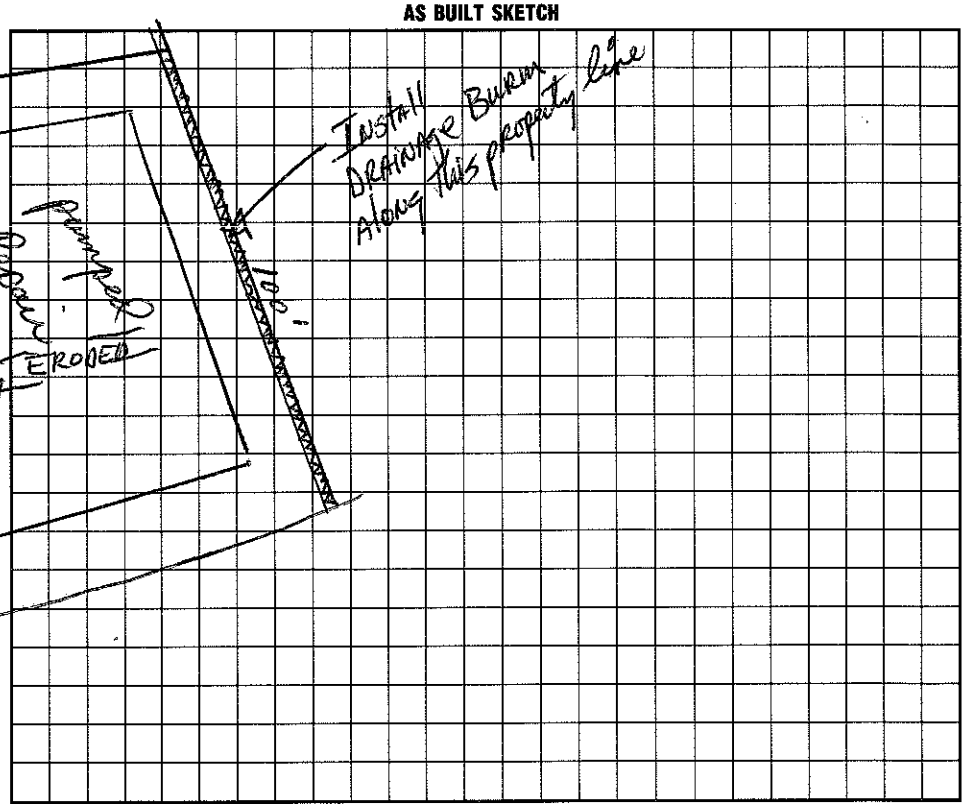

I understand that this permit can be suspended or revoked if any false information is supplied toward securing the permit/any unauthorized changes are made to the site/any unauthorized changes are made in the installation of the system. Improvement Permit is valid for 60 months from date of issuance.

Signed: X

Improvement Permit by: RS date 7/31/97

~~Construction Existing System Inspection by:~~ Authorization RS date 5-14-01

Installed by: Richard Abernathy RS

Certificate of Completion by: Maria H. Watson RS date 8/15/2001

Operation Permit by: date

HEALTH DEPT. COPY: WHITE INSPECTION COPY (FINAL): GREEN OWNER COPY (FINAL): YELLOW INSPECTION COPY (INITIAL): PINK OWNER COPY (INITIAL): GOLD