IREDELL COUNTY HEALTH DEPARTMENT

STATESVILLE 704-878-5305 MOORESVILLE 704-664-5281

IMPROVEMENT PERMIT / AUTHORIZATION TO CONSTRUCT / OPERATION PERMIT / EXISTING SYSTEM INSPECTION

PERMIT# 072608 PIN# ~~4639 73 4550 (pt)~~ 4638-87-4899 DATE Aug 1, '98

OWNER OR CONTRACTOR Stumpy Creek LLC // Lakemont Homes – Mike Hayhurst PHONE: Business 633-6124 Home

ADDRESS 614 N. Main Salisbury, N.C. 28144

LOCATION Perth Rd. N. TR into Harbor Lg Landing Bear left on Right

SUBDIVISION Harbor Landing BLOCK / SECTION III LOT 49 & ½ of 48 LOT AREA ~40,000 ft² SITE CLASS. PS DESIGN FLOW 360 gpd. L.T.A.R. .3

Septic Tank: 1000 Gallons; STB 312 Date

Pump Tank: Gallons; PT Date

Pump Make: Model Serial No.

Nitrification Field: No Fields 1 Square Feet 900 Linear Feet 300

No Lines 3@100' Trench Width 36" Max Trench Bottom Depth 24"

☑ New System ☐ Repair System Type: I, II, III, IV, V, VI

System Description: Gravity 25% Reduction

Repair System Description: Grav/pumped 25% Reduction

Maintenance Agreement Required: ☐ Yes ☑ No

Gravel Depth N/A

☑ House/Mod. Home No. Bedrooms 3

☐ Mobile Home No. Bathrooms 2

☐ Business No. Employees

☐ Other

☐ Slab ☑ Crawl Space ☐ Basement w/plumbing ☐ Basement wo/plumbing


Water Supply: ☐ Individual ☑ Public ☑ Community

Comments:/Conditions: * ONE Inspection/observation port per Lateral. Remove old Burns/Terraces ~180'

Comments:/Conditions:

1"=60'

INITIAL SITE SKETCH

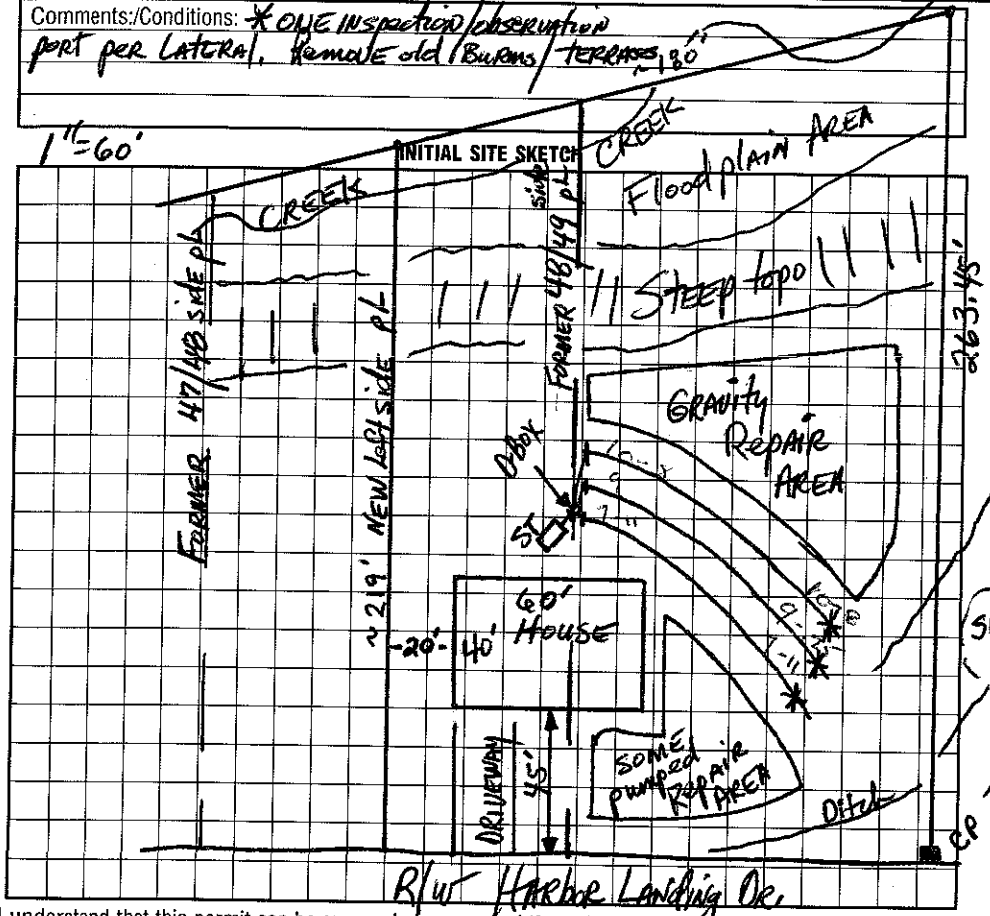

AS BUILT SKETCH

I understand that this permit can be suspended or revoked if any false information is supplied toward securing the permit/any unauthorized changes are made to the site/any unauthorized changes are made in the installation of the system. Improvement Permit with plat valid without expiration. Improvement Permit with site plan valid for sixty months. Authorization to Construct is valid for a period equal to that of Improvement Permit – not to exceed sixty months.

Signed: date

Improvement Permit by: RS date 8-1-98

Authorization to Construct by: RS date 8-20-99

Installed by: Larry Beam

Operation Permit by: Wesley Sparks RS. date 12/28/97

Existing System Inspection by: date

HEALTH DEPT. COPY: WHITE INSPECTION COPY (FINAL): GREEN OWNER COPY (FINAL): YELLOW INSPECTION COPY (INITIAL): PINK OWNER COPY (INITIAL): GOLD