IREDELL COUNTY HEALTH DEPARTMENT

STATESVILLE 704-878-5305 MOORESVILLE 704-664-5281

IMPROVEMENT PERMIT / AUTHORIZATION TO CONSTRUCT / OPERATION PERMIT / EXISTING SYSTEM INSPECTION

PERMIT# 072594 PIN# ~~4639-73-4550~~ (pt.) 4638-87-5153 DATE July 24, '98

OWNER OR CONTRACTOR Stumpy Creek LLC PHONE: Business 633-6124 Home

ADDRESS 614 N. Main St Salisbury N.C. 28144

LOCATION Perth Rd. N. TR Harbor Landing Dr. on left

SUBDIVISION Harbor Landing BLOCK / SECTION III LOT 38 LOT AREA 22,872 ft² SITE CLASS PS DESIGN FLOW 360 gpd L.T.A.R. .3

Septic Tank: 1000 Gallons; STB 825 Date 2/17/00

Pump Tank: Gallons; PT Date

Pump Make: Model Serial No.

Nitrification Field: No Fields 1 Square Feet 900 Linear Feet 300

No Lines 3@100' Trench Width 36" Max Trench Bottom Depth 30"

☑ New System ☐ Repair System Type: I, II, III, IV, V, VI

System Description: Gravity 25% Reduction

Repair System Description: Same

Maintenance Agreement Required: ☐ Yes ☑ No

Gravel Depth NA ☐ Slab ☑ Crawl Space ☐ Basement w/plumbing ☐ Basement wo/plumbing

☑ House/Mod. Home No. Bedrooms 3

☐ Mobile Home No. Bathrooms 2

☐ Business No. Employees

☐ Other

Water Supply: ☐ Individual ☑ Public ☐ Community

Comments:/Conditions: X ONE INSPECTION/OBSERVATION PORT PER LATERAL

Remove any old Burms/Terraces

Comments:/Conditions: ST - 6ft from House

Drainfield starts 9ft off HSE


2nd line 9ft from corner of HSE

1st line 9ft above corner of HSE

3rd line 8ft off exist steps

1"=60'

INITIAL SITE SKETCH

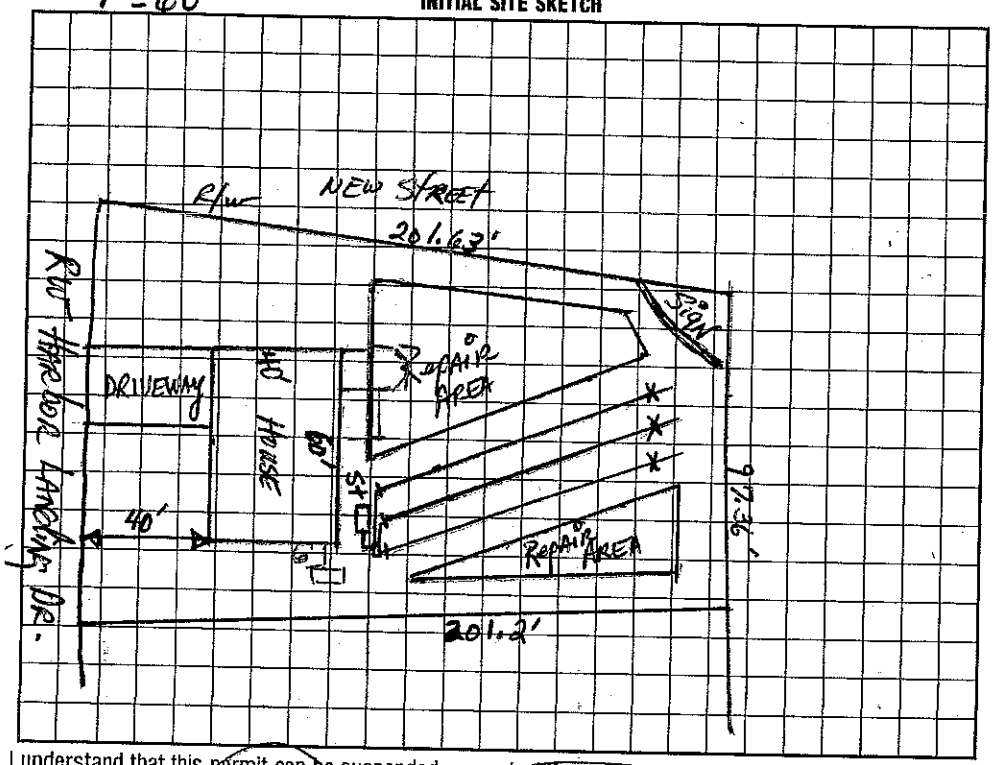

AS BUILT SKETCH

I understand that this permit can be suspended or revoked if any false information is supplied toward securing the permit/any unauthorized changes are made to the site/any unauthorized changes are made in the installation of the system. Improvement Permit with plat valid without expiration. Improvement Permit with site plan valid for sixty months. Authorization to Construct is valid for a period equal to that of Improvement Permit – not to exceed sixty months.

Signed: X date

Improvement Permit by: Wayne Hunter RS date 7-24-98

Authorization to Construct by: C. Ebby Hunter RS date 10/28/99

Installed by: Rowan Septic Tank

Operation Permit by: Wesley Sparks RS date 3/31/00

Existing System Inspection by: date

HEALTH DEPT. COPY: WHITE INSPECTION COPY (FINAL): GREEN OWNER COPY (FINAL): YELLOW INSPECTION COPY (INITIAL): PINK OWNER COPY (INITIAL): GOLD