(4:00) last time

IREDELL COUNTY HEALTH DEPARTMENT

STATESVILLE 704-878-5305 MOORESVILLE 704-664-5281

IMPROVEMENT PERMIT / AUTHORIZATION TO CONSTRUCT / OPERATION PERMIT / EXISTING SYSTEM INSPECTION

PERMIT# 072595 PIN# ~~4639-43-4550 (pt.)~~ 4638-87-5234 DATE July 24, '98

OWNER OR CONTRACTOR Stumpy Creek, LLC / Bill Jenkins PHONE: Business 633-6124 Home

ADDRESS 614 N. Main St Salisbury 28144

LOCATION Perth Rd N. TR into Harbor Landing - bear left on left

SUBDIVISION Harbor Landing BLOCK / SECTION III LOT 39 LOT AREA 23,163 ft² SITE CLASS. PS DESIGN FLOW 360 gpd L.T.A.R. = 3

Septic Tank: 1000 Gallons; STB 714 Date 10/30/98
Pump Tank: Gallons; PT Date
Pump Make: Model Serial No.
Nitrification Field: No Fields 1 Square Feet 900 Linear Feet 300
No Lines 3 @ 100' Trench Width 36" Max Trench Bottom Depth 30"

☑ New System ☐ Repair System Type: I, II, III, IV, V, VI
System Description: GRAVITY 25% Reduction
Repair System Description: SAME
Maintenance Agreement Required: ☐ Yes ☑ No
Gravel Depth NA

☑ House/Mod. Home No. Bedrooms 3
☐ Mobile Home No. Bathrooms 2
☐ Business No. Employees
☐ Other
☐ Slab ☑ Crawl Space ☐ Basement w/plumbing ☐ Basement wo/plumbing


Water Supply: ☐ Individual ☑ Public ☐ Community

Comments:/Conditions: ~~X~~ ONE INSpection/observation port per LATERAL
Remove old Berms/Terraces. INSTALL new Berm/Ditch Along Right side property LINE. (Stormwater)

Comments:/Conditions:

1" = 60'

INITIAL SITE SKETCH

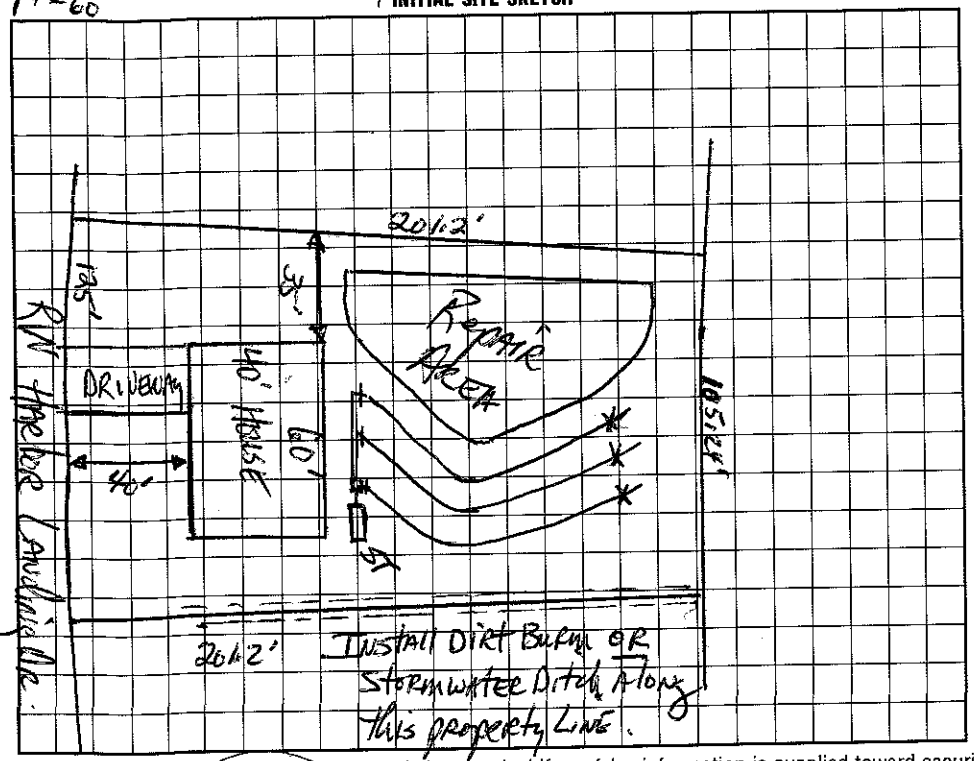

AS BUILT SKETCH

I understand that this permit can be suspended or revoked if any false information is supplied toward securing the permit/any unauthorized changes are made to the site/any unauthorized changes are made in the installation of the system. Improvement Permit with plat valid without expiration. Improvement Permit with site plan valid for sixty months. Authorization to Construct is valid for a period equal to that of Improvement Permit – not to exceed sixty months.

Signed: ~~X~~ date

Improvement Permit by: date 7-24-98

Construct by: date 11/25/98

Installed by: K & K GRADING

Operation Permit by: date 12/2/98

Existing System Inspection by: date

DEPT. COPY: WHITE INSPECTION COPY (FINAL): GREEN OWNER COPY (FINAL): YELLOW INSPECTION COPY (INITIAL): PINK OWNER COPY (INITIAL): GOLD