IREDELL COUNTY HEALTH DEPARTMENT

STATESVILLE 704-878-5305 MOORESVILLE 704-664-5281

IMPROVEMENT PERMIT / AUTHORIZATION TO CONSTRUCT / OPERATION PERMIT / EXISTING SYSTEM INSPECTION

PERMIT# 072596 PIN# ~~4639734550 (Lt)~~ 4638-87-5306 DATE 6-23-99

OWNER OR CONTRACTOR Stumpy Creek LLC PHONE: Business 633-6124 Home

ADDRESS 614 N. Main Salisbury NC 28144

LOCATION Perth Rd, TR Harbour landing, Lt on Lt

SUBDIVISION Harbor Landing BLOCK / SECTION III LOT 40 LOT AREA 23,163 ft² SITE CLASS. P5 DESIGN FLOW 360 L.T.A.R. .3

Septic Tank: 1000 Gallons; STB 794 Date 4/19/00
Pump Tank: ____ Gallons; PT ____ Date ____
Pump Make: ____ Model ____ Serial No. ____
Nitrification Field: No Fields 1 Square Feet 900 Linear Feet 300
No Lines 4@75 Trench Width 36 Max Trench Bottom Depth 36

☒ New System ☐ Repair System Type: I, II, (III), IV, V, VI
System Description: 25% Red X
Repair System Description: 25% Red X / Panel
Maintenance Agreement Required: ☐ Yes ☐ No

☒ House/Mod. Home No. Bedrooms 3
☐ Mobile Home No. Bathrooms 2
☐ Business No. Employees ____
☐ Other ____


Gravel Depth N/A ☐ Slab ☒ Crawl Space ☐ Basement w/plumbing ☐ Basement wo/plumbing

Water Supply: ☐ Individual ☒ ~~Public~~ ☒ Community

Comments:/Conditions: one inspection port per line

Comments:/Conditions:

INITIAL SITE SKETCH

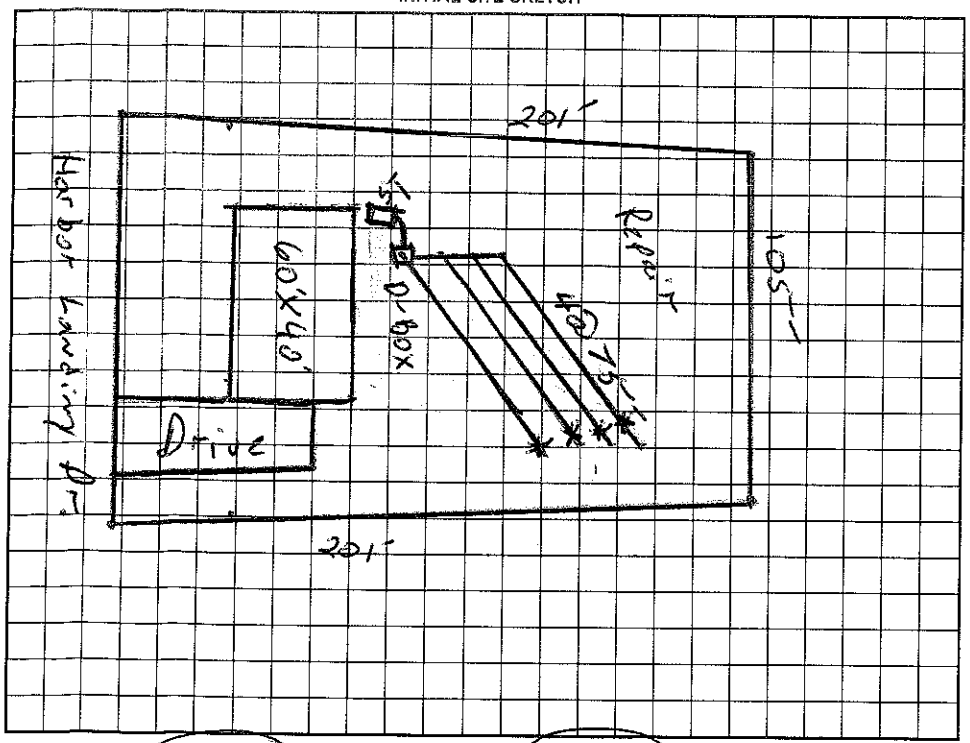

AS BUILT SKETCH

Permit can be suspended or revoked if any false information is supplied toward securing the permit/any unauthorized changes are made to the site/any unauthorized changes are made in the installation of the system. Improvement Permit with plat valid without expiration. Improvement Permit with site plan valid for sixty months. Authorization to Construct is valid for a period equal to that of Improvement Permit – not to exceed sixty months.

Signed: ____ date ____

Improvement Permit by: Jeff Mogan date 6-23-99

Authorization to Construct by: Jeff Mogan date 6-23-99

Installed by: Larry Beam

Operation Permit by: Wesley Sparks RS. date 5/31/00

Existing System Inspection by: ____ date ____

HEALTH DEPT. COPY: WHITE OWNER COPY (FINAL): YELLOW OWNER COPY (INITIAL): PINK