IREDELL COUNTY HEALTH DEPARTMENT

STATESVILLE 704-878-5305 MOORESVILLE 704-664-5281

IMPROVEMENT PERMIT / AUTHORIZATION TO CONSTRUCT / OPERATION PERMIT / EXISTING SYSTEM INSPECTION

PERMIT# 072617 PIN# ~~4639 73 4550 (ph)~~ 4638-87-1087 DATE July 31, '98

OWNER OR CONTRACTOR Stumpy Creek LLC (MARK HARPER CONST.) PHONE: Business _____ Home _____

ADDRESS 614 N. Main St. Salisbury, N.C. 28144

LOCATION Perth Rd. N. TR into Harbor Landing at intersection across from main entrance

SUBDIVISION Harbor Landing BLOCK / SECTION III LOT 56 LOT AREA 26,709 ft² SITE CLASS. PS DESIGN FLOW 360gpd L.T.A.R. .03

Septic Tank: 1000 Gallons; STB 794 Date 2/23/99

Pump Tank: _____ Gallons; PT _____ Date _____

Pump Make: _____ Model _____ Serial No. _____

Nitrification Field: No Fields 1 Square Feet 900 Linear Feet 300

No Lines 4@75' Trench Width 36" Max Trench Bottom Depth 36" Gravel Depth NA

☑ New System ☐ Repair System Type: I, II, (III), IV, V, VI

System Description: Gravity 25% Reduction

Repair System Description: SAME

Maintenance Agreement Required: ☐ Yes ☑ No

☑ House/Mod. Home No. Bedrooms 3

☐ Mobile Home No. Bathrooms 2

☐ Business No. Employees _____

☐ Other _____

☐ Slab ☑ Crawl Space ☐ Basement w/plumbing ☐ Basement wo/plumbing


Water Supply: ☐ Individual ☑ Public ☑ ~~Community~~

Comments:/Conditions: Remove old Burns / Terraces. Install Stormwater Drainage Ditch / Berm Along Side property Lines and along rear property line.

Comments:/Conditions:

1" = 60'

INITIAL SITE SKETCH

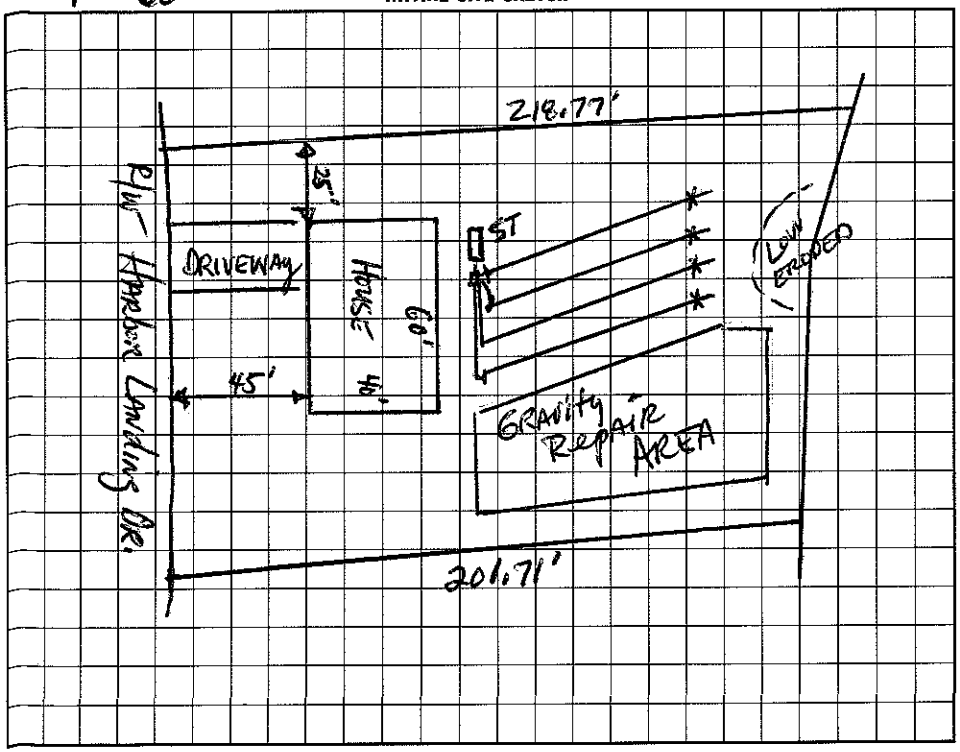

AS BUILT SKETCH

I understand that this permit can be suspended or revoked if any false information is supplied toward securing the permit/any unauthorized changes are made to the site/any unauthorized changes are made in the installation of the system. Improvement Permit with plat valid without expiration. Improvement Permit with site plan valid for sixty months. Authorization to Construct is valid for a period equal to that of Improvement Permit – not to exceed sixty months.

Signed: _____ date _____ Installed by: Larry Bacon

Improvement Permit by: _____ date 7-31-98 Operation Permit by: Wesley Sparks R.S. date 4/12/99

Authorization to Construct by: _____ date 8/5/98 Existing System Inspection by: _____ date _____

HEALTH DEPT. COPY: WHITE INSPECTION COPY (FINAL): GREEN OWNER COPY (FINAL): YELLOW INSPECTION COPY (INITIAL): PINK OWNER COPY (INITIAL): GOLD