IREDELL COUNTY HEALTH DEPARTMENT

STATESVILLE 704-878-5305 MOORESVILLE 704-664-5281

IMPROVEMENT PERMIT / AUTHORIZATION TO CONSTRUCT / OPERATION PERMIT / EXISTING SYSTEM INSPECTION

(4,100)

PERMIT# 072615 PIN# ~~4639-73-4530 (pt.)~~ 4638-87-7373 DATE July 31, 1998

OWNER OR CONTRACTOR Stumpy Creek LLC PHONE: Business 633-6124 Home

ADDRESS 614 N. Main / Salisbury, N.C. 28144

LOCATION Perth Rd. N. TR into Harbor Landing BEAR left on Right

SUBDIVISION Harbor Landing BLOCK / SECTION III LOT 54 LOT AREA 39,470 ft² SITE CLASS. PS DESIGN FLOW 480gpd L.T.A.R. .3

Septic Tank: 1000 Gallons; STB 825 Date 3/4/99

Pump Tank: Gallons; PT Date

Pump Make: Model Serial No.

Nitrification Field: No Fields 1 Square Feet 1620 Linear Feet 540

No Lines 5@108' Trench Width 36" Max Trench Bottom Depth 36"

☑ New System ☐ Repair System Type: I, II, III, IV, V, VI

System Description: Gravity Conventional

Repair System Description: SAME

Maintenance Agreement Required: ☐ Yes ☑ No

Gravel Depth 12"

☑ House/Mod. Home No. Bedrooms 4

☐ Mobile Home No. Bathrooms 3

☐ Business No. Employees

☐ Other

☐ Slab ☑ Crawl Space ☐ Basement w/plumbing ☐ Basement wo/plumbing


Water Supply: ☐ Individual ☑ Public ☐ Community

Comments:/Conditions: Remove old Basems / TERRACES

Comments:/Conditions:

1"=60'

INITIAL SITE SKETCH

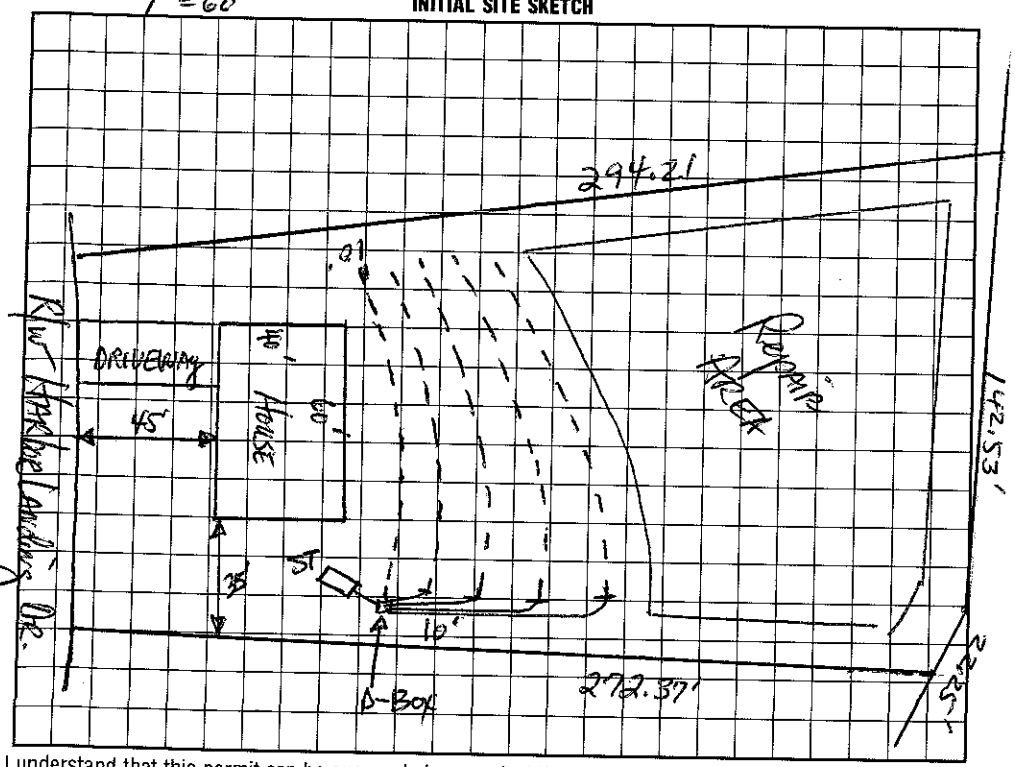

AS BUILT SKETCH

I understand that this permit can be suspended or revoked if any false information is supplied toward securing the permit/any unauthorized changes are made to the site/any unauthorized changes are made in the installation of the system. Improvement Permit with plat valid without expiration. Improvement Permit with site plan valid for sixty months. Authorization to Construct is valid for a period equal to that of Improvement Permit – not to exceed sixty months.

Signed: date

Improvement Permit by: Marvell Hunter, RS date 7-31-98

Authorization to Construct by: date 12/11/98

Installed by: ROWAN SEPTIC

Operation Permit by: Jeff Morgan date 5/27/99

Existing System Inspection by: date

HEALTH DEPT. COPY: WHITE INSPECTION COPY (FINAL): GREEN OWNER COPY (FINAL): YELLOW INSPECTION COPY (INITIAL): PINK OWNER COPY (INITIAL): GOLD