4:00

IREDELL COUNTY HEALTH DEPARTMENT

STATESVILLE 704-878-5305 MOORESVILLE 704-664-5281

IMPROVEMENT PERMIT / AUTHORIZATION TO CONSTRUCT / OPERATION PERMIT / EXISTING SYSTEM INSPECTION

PERMIT# 072613 PIN# ~~4639-73-4550 (pt.)~~ 4638-87-7527 DATE July 31, '98

OWNER OR CONTRACTOR Stumpy Creek LLC PHONE: Business 633-6124 Home

ADDRESS 614 N. Main St Salisbury, N.C. 28144

LOCATION Peeler Rd N. TR into Harbor Landing Bear left on Right

SUBDIVISION Harbor Landing BLOCK / SECTION III LOT 52 LOT AREA 41,397 ft² SITE CLASS. 15 DESIGN FLOW 480gpd L.T.A.R. .3

Septic Tank: 1000 Gallons; STB 825 Date 9/12/98

Pump Tank: Gallons; PT Date

Pump Make: Model Serial No.

Nitrification Field: No Fields 2 Square Feet 1620 Linear Feet 540

No Lines 3+3 (90°) Trench Width 36" Max Trench Bottom Depth 24" Gravel Depth 21"

☑ New System ☐ Repair System Type: I, II, III, IV, V, VI

System Description: Gravity Conventional

Repair System Description: GPAW / CONV / 25% Red.

Maintenance Agreement Required: ☐ Yes ☑ No

☑ House/Mod. Home No. Bedrooms 4

☐ Mobile Home No. Bathrooms 3

☐ Business No. Employees

☐ Other

☐ Slab ☑ Crawl Space ☐ Basement w/plumbing ☐ Basement wo/plumbing


Water Supply: ☐ Individual ☑ Public ☑ Community

Comments:/Conditions: Flow Divider to 2 D-Boxes w/ Speed levelers
Remove any old Berms/Terraces

Comments:/Conditions:

1" = 60'

INITIAL SITE SKETCH

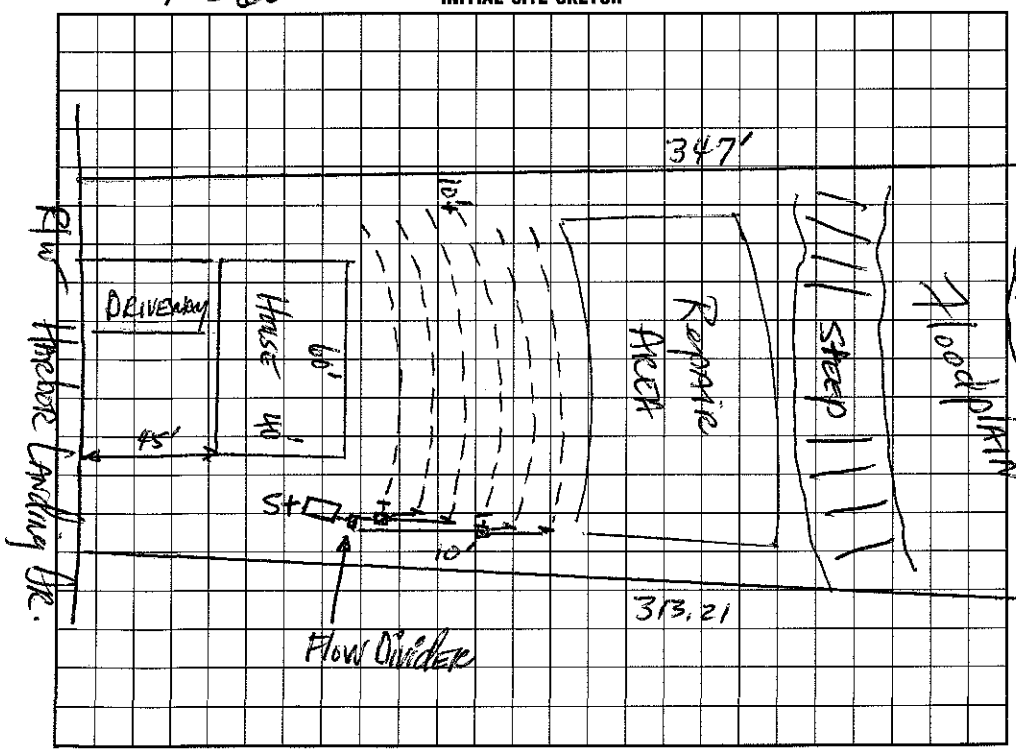

AS BUILT SKETCH

I understand that this ~~permit~~ can be suspended or revoked if any false information is supplied toward securing the permit/any unauthorized changes are made to the site/any unauthorized changes are made in the installation of the system. Improvement Permit with plat valid without expiration. Improvement Permit with site plan valid for sixty months. Authorization to Construct is valid for a period equal to that of Improvement Permit – not to exceed sixty months.

Signed: date 11/13/98 Installed by: Rowan Septic

Improvement Permit by: date 7-31-98 Operation Permit by: Jeff Morgan date 4/6/99

Authorization to Construct by: date 11-12-98 Existing System Inspection by: date

HEALTH DEPT. COPY: WHITE INSPECTION COPY (FINAL): GREEN OWNER COPY (FINAL): YELLOW INSPECTION COPY (INITIAL): PINK OWNER COPY (INITIAL): GOLD