IREDELL COUNTY HEALTH DEPARTMENT

STATESVILLE 704-878-5305 MOORESVILLE 704-664-5281

IMPROVEMENT PERMIT / AUTHORIZATION TO CONSTRUCT / OPERATION PERMIT / EXISTING SYSTEM INSPECTION

PERMIT# 072-709 PIN# 4639734550 4638 88 0087 DATE Nov. 19 '98

OWNER OR CONTRACTOR Stumpy Creek LLC (VAN EDWARDS CONST. PHONE: Business 664-9868 Home

ADDRESS 614 N. Main Salisbury 28144

LOCATION Perth Rd N. TR Harbor Landing OR. Beaufort on left 203 Harbor Landing 360 Ave S

SUBDIVISION Harbor Landing BLOCK / SECTION 4 LOT 61 LOT AREA 25,683 ft² SITE CLASS. PS DESIGN FLOW ~~480 gpd~~ L.T.A.R. .025-03

Septic Tank: 1000 Gallons; STB 825 Date 6/21/00

Pump Tank: 1000 Gallons; PT 30" Date 8/20/00

Pump Make: ZOELLER Model N-98L Serial No.

Nitrification Field: No Fields 1 Square Feet ~~1260~~ 900 Linear Feet ~~420~~ 300

No Lines ~~4 Beds~~ 3 Trench Width 36" Max Trench Bottom Depth 36" Gravel Depth ~~STONE~~ SAND

☑ New System ☐ Repair System Type: I, II, III, IV, V, VI

System Description: pumped pressure to Rock trench

Repair System Description: SAME

Maintenance Agreement Required: ☐ Yes ☑ No

☑ House/Mod. Home ☑ Mobile Home ☐ Business ☐ Other

No. Bedrooms ~~4~~ 3 No. Bathrooms 2.5 No. Employees

Water Supply: ☐ Individual ☑ Public ☑ Community

☐ Slab ☑ Crawl Space ☐ Basement w/plumbing ☐ Basement wo/plumbing


Comments/Conditions: * DHE inspection report per Lateral.
Remove any old burns, fences, etc.

*4/7/00 Revised Plan - House 3BD. Mound 400 sq ft
111=60'

Comments/Conditions:

INITIAL SITE SKETCH conventional trench bottom Ave S

8/14/00 - Site now requires 300' Chem. Plastic Ave S

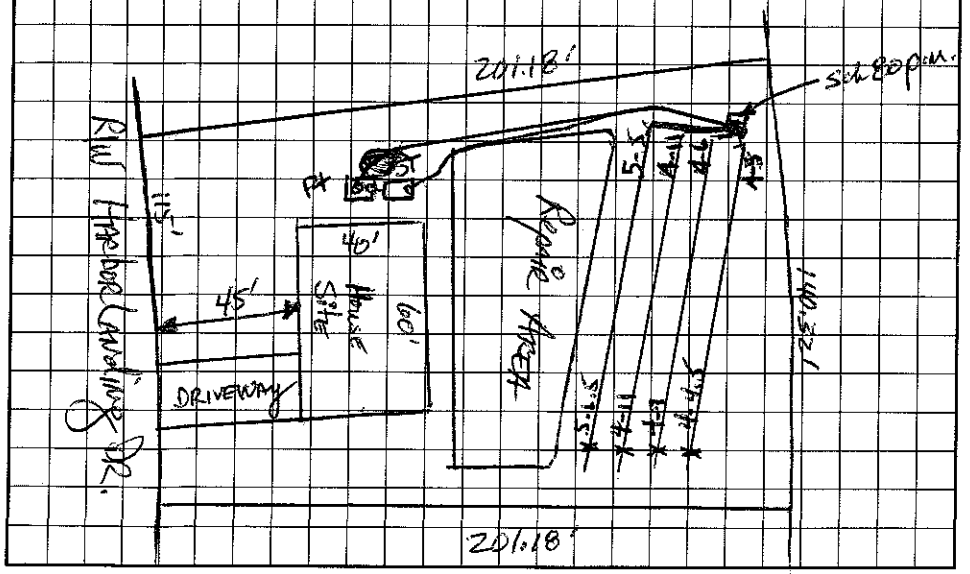

AS BUILT SKETCH

I understand that this permit can be suspended or revoked if any false information is supplied toward securing the permit/any unauthorized changes are made to the site/any unauthorized changes are made in the installation of the system. Improvement Permit with plat valid without expiration. Improvement Permit with site plan valid for sixty months. Authorization to Construct is valid for a period equal to that of Improvement Permit – not to exceed sixty months.

Signed: date 11/25/98 Installed by: Rowan Septic Tank

Improvement Permit by: date 11-9-98 Operation Permit by: Wesley Sparks RS. date 2/14/01

Authorization to Construct by: Wesley Sparks RS date 4/7/00 Existing System Inspection by: date

HEALTH DEPT. COPY: WHITE INSPECTION COPY (FINAL): GREEN OWNER COPY (FINAL): YELLOW INSPECTION COPY (INITIAL): PINK OWNER COPY (INITIAL): GOLD