4100

IREDELL COUNTY HEALTH DEPARTMENT

STATESVILLE 704-878-5305 MOORESVILLE 704-664-5281

IMPROVEMENT PERMIT / AUTHORIZATION TO CONSTRUCT / OPERATION PERMIT / EXISTING SYSTEM INSPECTION

PERMIT# 072710 PIN# 4639734550 4638 88 0149 DATE Nov. 19, '98

OWNER OR CONTRACTOR Stumpy Creek LLC // Gary Manus PHONE: Business 528-4270 Home

ADDRESS 614 N. Main Salisbury 28144

LOCATION North Rd N. TR Harbor Landing Dr. Bear left on left

SUBDIVISION Harbor Landing BLOCK / SECTION 4 LOT 62 LOT AREA 25,683 ft² SITE CLASS. RS DESIGN FLOW 480gpd L.T.A.R. .25-.3 3 BRK

Septic Tank: 1000 Gallons; STB 825 Date 6-19-98
Pump Tank: 1000 Gallons; PT 302 Date 7-16-98
Pump Make: Zoeller Model N98 Serial No. ~~2004~~
Nitrification Field: No Fields ___ Square Feet 1260 ~~945~~ Linear Feet ~~420~~ 315
No Lines 3 @ 105' Trench Width 36" Max Trench Bottom Depth ~30"

☑ New System ☐ Repair System Type: I, II, III, IV, V, VI
System Description: Pumped-pm-25% Red Innovative
Repair System Description: 1 Panel Block
Maintenance Agreement Required: ☐ Yes ☑ ~~No~~
Gravel Depth N/A

☑ ~~House/Mod. Home~~ No. Bedrooms ~~4~~ 3
☐ Mobile Home No. Bathrooms ~~3.5~~ 2.5
☐ Business No. Employees ___
☐ Other ___
☐ Slab ☑ ~~Crawl Space~~ ☐ Basement w/plumbing ☐ Basement wo/plumbing


Water Supply: ☐ Individual ☑ ~~Public~~ ☑ Community

Comments:/Conditions: * One Inspection port per lateral.
Remove any old berms, terraces.
5-8-00 Reviewed house plan - 3 Bedrooms total - OK to reduce system size to 3 laterals @ 105'


Comments:/Conditions: Tanks & Lines Checked 8/30/00
Pressure Checked 8/30/00

1" = 60'

INITIAL SITE SKETCH House footprint 54' deep including deck. BRK

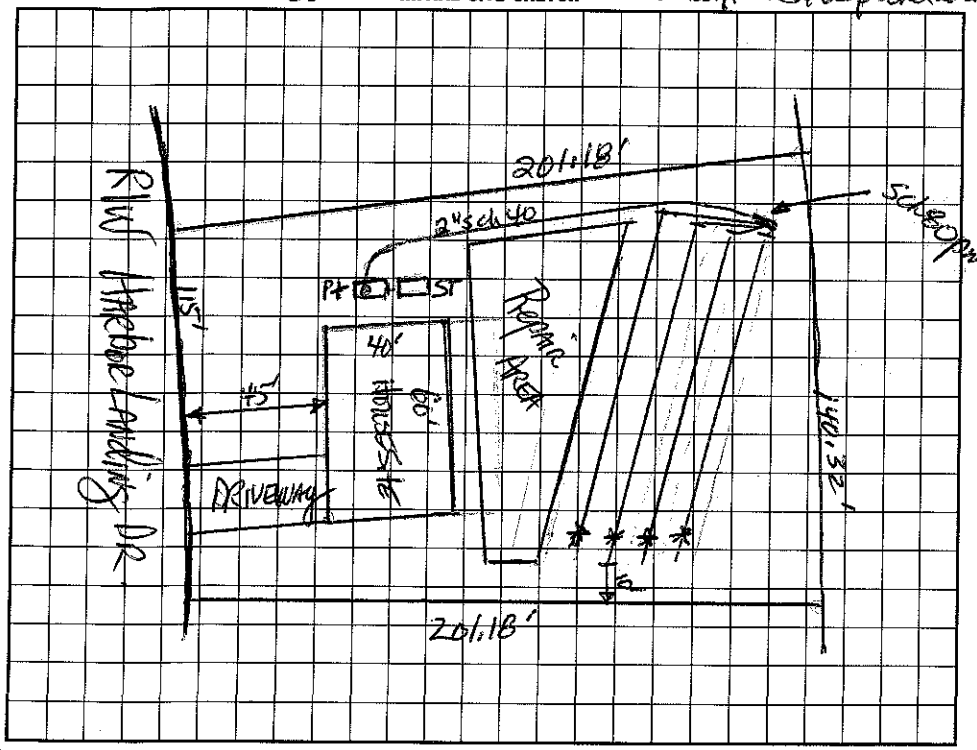

AS BUILT SKETCH

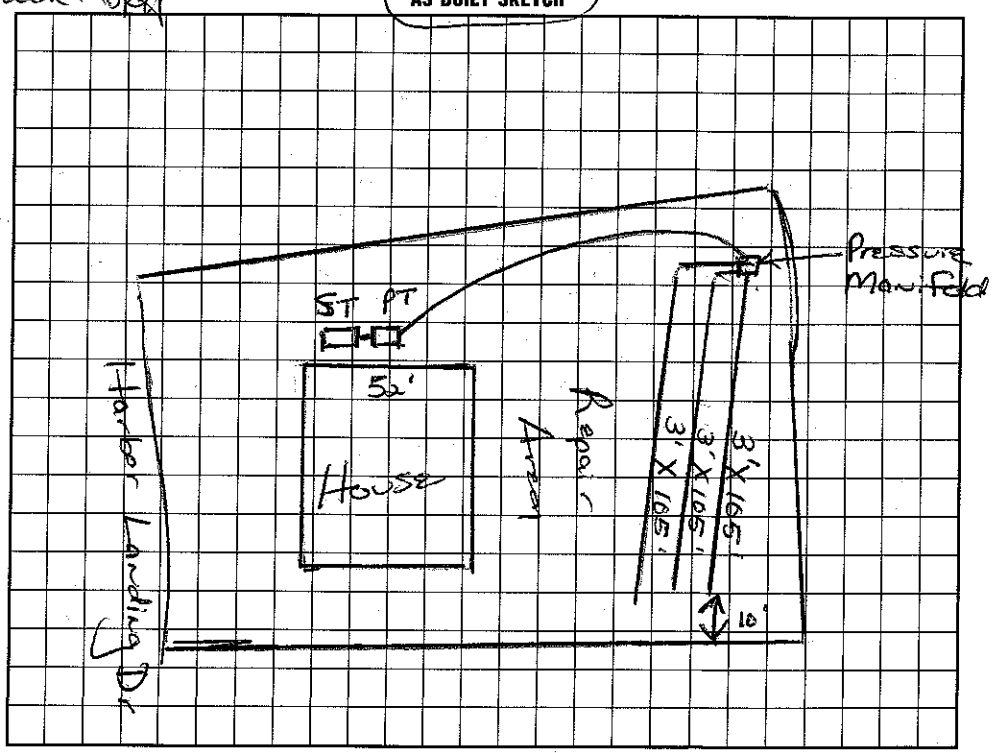

I understand that this permit can be suspended or revoked if any false information is supplied toward securing the permit/any unauthorized changes are made to the site/any unauthorized changes are made in the installation of the system. Improvement Permit with ~~plat~~ valid without expiration. Improvement Permit with site plan valid for sixty months. Authorization to Construct is valid for a period equal to that of Improvement Permit – not to exceed sixty months.

Signed: ___ date 11/25/98 Installed by: Rowan Septic

Improvement Permit by: David R. Hansen, RS date 11-19-98 Operation Permit by: Wesley Sparks RS date 11/15/00

Authorization to Construct by: David R. Hansen, RS date 5-8-00 Existing System Inspection by: ___ date ___

HEALTH DEPT. COPY: WHITE INSPECTION COPY (FINAL): GREEN OWNER COPY (FINAL): YELLOW INSPECTION COPY (INITIAL): PINK OWNER COPY (INITIAL): GOLD