1400

IREDELL COUNTY HEALTH DEPARTMENT

STATESVILLE 704-878-5305 MOORESVILLE 704-664-5281

IMPROVEMENT PERMIT / AUTHORIZATION TO CONSTRUCT / OPERATION PERMIT / EXISTING SYSTEM INSPECTION

PERMIT# 072713 PIN# 4639734550 4638 88 0516 DATE Nov 18, 98

OWNER OR CONTRACTOR Stumpy Creek LLC PHONE: Business _____ Home _____

ADDRESS 614 N. Main Salisbury 28144

LOCATION Forth Rd. N. TR Harbor Landing Dr. Bear left on left

SUBDIVISION Harbor Landing BLOCK / SECTION 4 LOT 65 LOT AREA 24,101 sf SITE CLASS. PS DESIGN FLOW 360 gpd L.T.A.R. n. 3

Septic Tank: 1000 Gallons; STB 825 Date 8/13/99
Pump Tank: 1000 Gallons; PT 302 Date 8/2/99
Pump Make: Zoeller Model N-137C Serial No. _____
Nitrification Field: No Fields 1 Square Feet 900 Linear Feet 300
No Lines 3@10' Trench Width 36" Max Trench Bottom Depth 24" Gravel Depth NA

☑ New System ☐ Repair System Type: I, II, (III) IV, V, VI
System Description: Pumped-pm-25%Red/Innovative
Repair System Description: Stone
Maintenance Agreement Required: ☐ Yes ☑ No

☑ House/Mod. Home No. Bedrooms 3
☐ Mobile Home No. Bathrooms 2
☐ Business No. Employees _____
☐ Other _____

☐ Slab ☑ Crawl Space ☐ Basement w/plumbing ☐ Basement wo/plumbing


Water Supply: ☐ Individual ☑ Public ☐ Community

Comments/Conditions: * ONE INSPECTION PORT per LATERAL
Remove any old burning traces.
Fill ERODED future house site. DIVERT stormwater along side property lines.

Comments/Conditions:
Inspected lines, Tanks, Design and Pressure 12/29/99

1"=60'

INITIAL SITE SKETCH

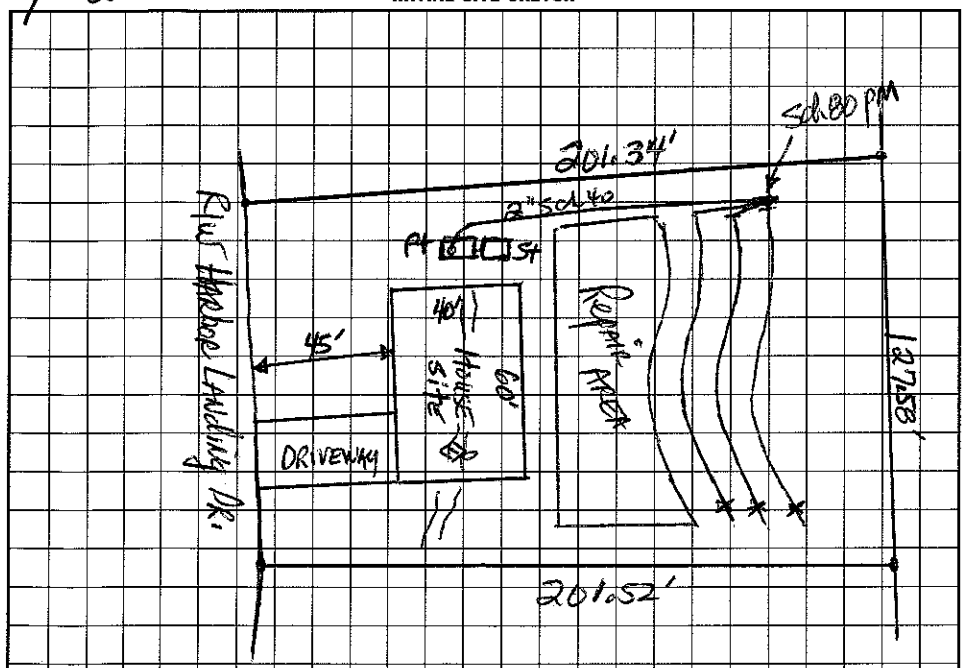

AS BUILT SKETCH

I understand that this permit can be suspended or revoked if any false information is supplied toward securing the permit/any unauthorized changes are made to the site/any unauthorized changes are made in the installation of the system. Improvement Permit with plat valid without expiration. Improvement Permit with site plan valid for sixty months. Authorization to Construct is valid for a period equal to that of Improvement Permit – not to exceed sixty months.

Signed: _____ date 11/25/98 Installed by: Rowan Septic Tank

Improvement Permit by: _____ date 11-19-98 Operation Permit by: _____ date 12/17/99

Authorization to Construct by: Wesley Sparks RS. date 8/2/99 Existing System Inspection by: _____ date _____

HEALTH DEPT. COPY: WHITE INSPECTION COPY (FINAL): GREEN OWNER COPY (FINAL): YELLOW INSPECTION COPY (INITIAL): PINK OWNER COPY (INITIAL): GOLD