4.00

DELL COUNTY HEALTH DEPARTMENT

STATESVILLE 704-878-5305 MOORESVILLE 704-664-5281

IMPROVEMENT PERMIT / AUTHORIZATION TO CONSTRUCT / OPERATION PERMIT / EXISTING SYSTEM INSPECTION

PERMIT# 072606 PIN# 4639734550 (pt) 4638883092 DATE 1-10-2000

OWNER OR CONTRACTOR Stumpy Creek LLC / Mike Clancy PHONE: Business 895-8980 Mike Home Mobile 634-6905

ADDRESS 614 N. Main Salisbury NC 28144

LOCATION Hwy 150 West TR Peach Rd TR Harbor Landing bear left on right

SUBDIVISION Harbor Landing BLOCK / SECTION III LOT 47 (half of 48) LOT AREA .777 Ac SITE CLASS. PS DESIGN FLOW 480gpd T.A.R. .3

Septic Tank: 1000 Gallons; STB _____ Date 12-10-01

Pump Tank: 1000 Gallons; PT 302 Date 1-15-02

Pump Make: Zoeller Model N140 Serial No. _____

Nitrification Field: No Fields 1 Square Feet 1200' Linear Feet 400'

No Lines 8 at 50' Trench Width 36" Max Trench Bottom Depth 36" Gravel Depth N/A

[X] New System [ ] Repair System Type: I, II, III, IV, V, VI

System Description: Pump (PM) 25% Reduction *

Repair System Description: LPP (Pumped) - Panel Block

Maintenance Agreement Required: [ ] Yes [X] No Not Initially

[X] House/Mod. Home [ ] Mobile Home [ ] Business [ ] Other


No. Bedrooms 4 No. Bathrooms 2.5 No. Employees ____

[ ] Slab [ ] Crawl Space [X] Basement w/plumbing [ ] Basement wo/plumbing

Water Supply: [ ] Individual [X] Public [X] Community

Comments:/Conditions: Keep Septic System at least 10' from PL & 25' upgradient of basement or 15' side gradient & 5' down gradient of basement.

INITIAL SITE SKETCH Scale 1:60

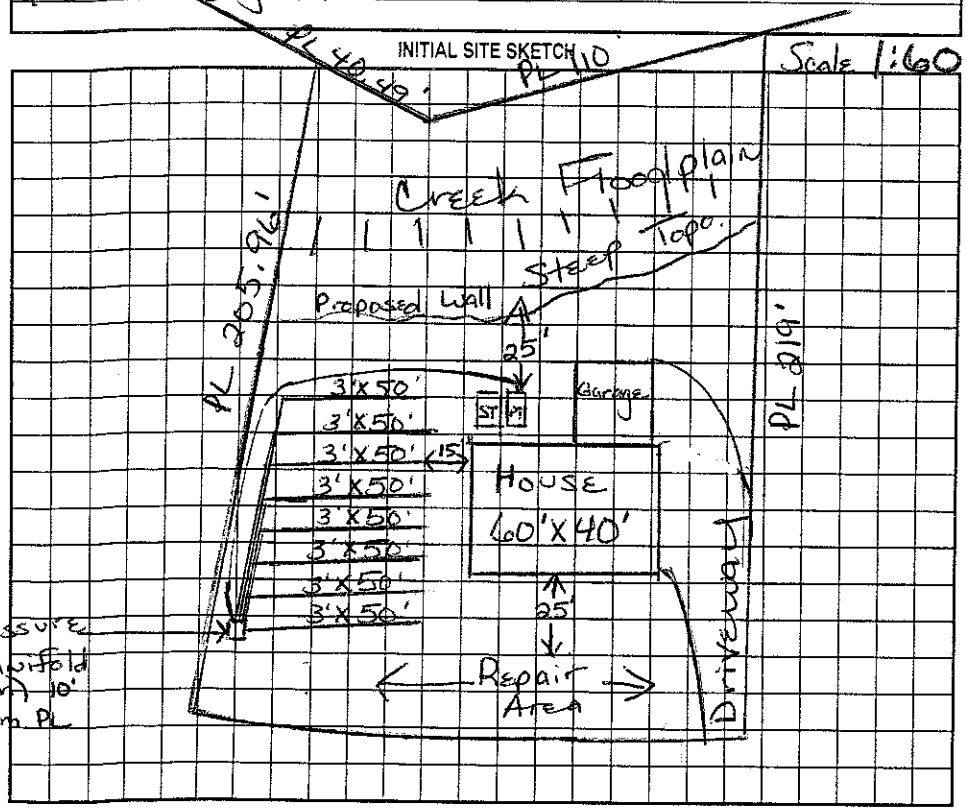

Comments:/Conditions: Keep tanks & Drainfield at least 25' From Retaining Wall. Install drainlines 9ft on center. Replaces previously issued permit, dated 8/1/98.
* 25% Reduction in Drainfield area.

AS BUILT SKETCH

Pressure Checked Tanks & Lines 6/12/2002
(Used 2 boxes & piped together for PM)
Installed as Drawn
Used 11 Plastic Chambers

Permit can be suspended or revoked if any false information is supplied toward securing the permit/any unauthorized changes are made to the site/any unauthorized changes are made in the installation of the system. Improvement Permit with plat valid without expiration. Improvement Permit with site plan valid for sixty months. Authorization to Construct is valid for a period equal to that of Improvement Permit – not to exceed sixty months.

Signed: _____ date 1-19-00 Installed by: Rowan Septic

Improvement Permit by: _____ date 1/10/2000 Operation Permit by: _____ date 9/26/02

Authorization to Construct by: _____ date 1/11/2000 Existing System Inspection by: _____ date _____

HEALTH DEPT. COPY: WHITE OWNER COPY (FINAL): YELLOW OWNER COPY (INITIAL): PINK