IREDELL COUNTY HEALTH DEPARTMENT

STATESVILLE 704-878-5305 MOORESVILLE 704-664-5281

IMPROVEMENT PERMIT / AUTHORIZATION TO CONSTRUCT / OPERATION PERMIT / EXISTING SYSTEM INSPECTION

PERMIT# 072808 PIN# 4639734530 4658-88-3168 DATE Nov. 23, '98

OWNER OR CONTRACTOR Stumpy Creek LLC // Van Edward Const. PHONE: Business _____ Home _____

ADDRESS 614 N. Main Salisbury 28144

LOCATION 150 NJ TR South Rd. TR Harbor Landing Dr. Bear Left on Right

SUBDIVISION Harbor Landings BLOCK / SECTION 4 LOT 91 & ½ 90 LOT AREA ~32,000 ft² SITE CLASS. PS DESIGN FLOW 360 gpd L.T.A.R. .25

Septic Tank: 1000 Gallons; STB 312 Date 10/23/99

Pump Tank: _____ Gallons; PT _____ Date _____

Pump Make: _____ Model _____ Serial No. _____

Nitrification Field: No Fields 1 Square Feet 1080 Linear Feet 360

No Lines 4@90' Trench Width 36" Max Trench Bottom Depth 24" Gravel Depth NA

☑ New System ☐ Repair System Type: I, II, (III), IV, V, VI

System Description: GRAVITY 25% Reduction/Innovative

Repair System Description: SAME

Maintenance Agreement Required: ☐ Yes ☑ No

☑ House/Mod. Home No. Bedrooms 3

☐ Mobile Home No. Bathrooms 3

☐ Business No. Employees ____

☐ Other _____

☐ Slab ☑ Crawl Space ☐ Basement w/plumbing ☐ Basement wo/plumbing

Water Supply: ☐ Individual ☑ Public ☑ Community


Comments:/Conditions: * ONE INSPECTION port PER LATERAL

12-2-99 Reviewed site & home plan - substantially in compliance w/ IP (KH)

Comments:/Conditions:

INITIAL SITE SKETCH

1" = 60'

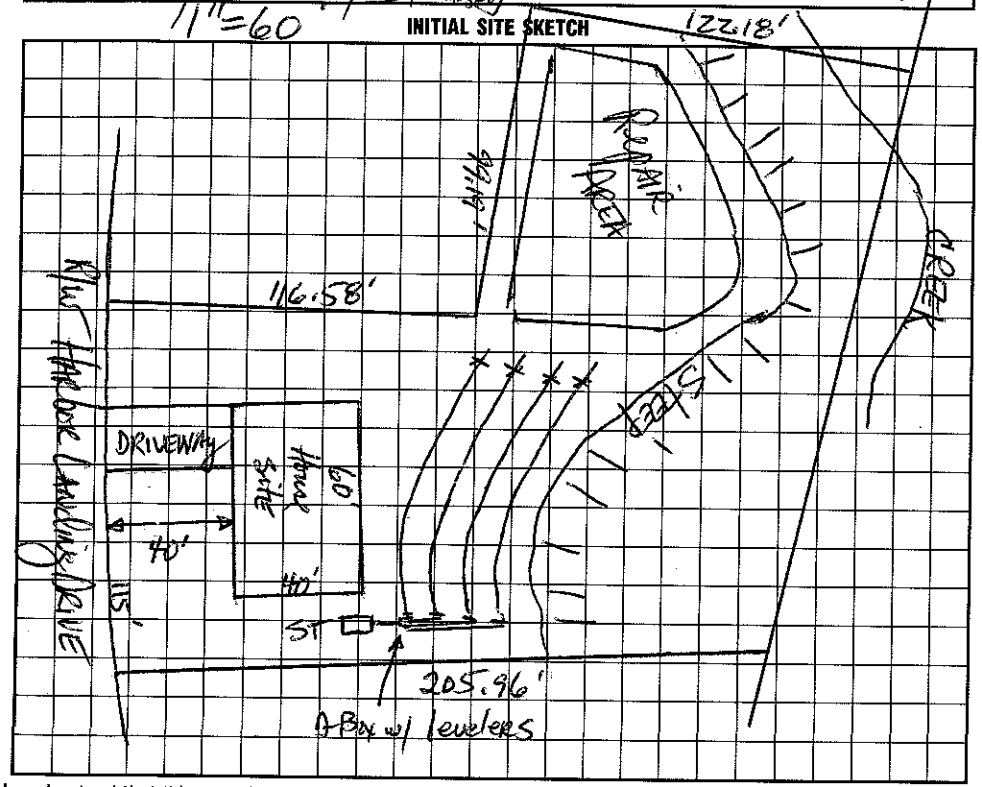

AS BUILT SKETCH

I understand that this permit can be suspended or revoked if any false information is supplied toward securing the permit/any unauthorized changes are made to the site/any unauthorized changes are made in the installation of the system. Improvement Permit with plat valid without expiration. Improvement Permit with site plan valid for sixty months. Authorization to Construct is valid for a period equal to that of Improvement Permit – not to exceed sixty months.

Signed: _____ date 11/25/98

Improvement Permit by: _____ date 11-23-98

Authorization to Construct by: _____ date 12-2-99

Installed by: Larry Beam

Operation Permit by: Wesley Sparks R.S. date 4/11/00

Existing System Inspection by: _____ date _____

HEALTH DEPT. COPY: WHITE INSPECTION COPY (FINAL): GREEN OWNER COPY (FINAL): YELLOW INSPECTION COPY (INITIAL): PINK OWNER COPY (INITIAL): GOLD