IREDELL COUNTY HEALTH DEPARTMENT

STATESVILLE 704-878-5305 (664-1476) MOORESVILLE 704-664-5281

IMPROVEMENT PERMIT / AUTHORIZATION TO CONSTRUCT / OPERATION PERMIT / EXISTING SYSTEM INSPECTION

PERMIT# 072718 PIN# 4639T3455D 4638 88 3913 DATE 10/21/98

OWNER OR CONTRACTOR Stumpy Creek LLC / Mark Harper PHONE: Business Home

ADDRESS 614 W. Marsh Salisbury 28144

LOCATION ISDW TR 13 Perth Rd. - TR Harbor Landing Dr. Been left on lot

SUBDIVISION Harbor Landing BLOCK / SECTION 4 LOT 69 LOT AREA 31066 ft² SITE CLASS. PS DESIGN FLOW 360gpd L.T.A.R. .3

Septic Tank: 1000 Gallons; STB 794 Date 10/29/99

Pump Tank: 1000 Gallons; PT 27 Date 3/3/00

Pump Make: HYDROMATIC Model SK-50 Serial No.

Nitrification Field: No Fields Square Feet 900 Linear Feet 300

No Lines 3@100 Trench Width 36" Max Trench Bottom Depth ~30" Gravel Depth NA

☑ New System ☐ Repair System Type: I, II, III, IV, V, VI

System Description: Pumped pm - 25% Red / INNOVATIVE

Repair System Description: SAME

Maintenance Agreement Required: ☐ Yes ☑ No

☑ House/Mod. Home No. Bedrooms 3

☐ Mobile Home No. Bathrooms 3

☐ Business No. Employees

☐ Other


☐ Slab ☑ Crawl Space ☐ Basement w/plumbing ☐ Basement wo/plumbing

Water Supply: ☐ Individual ☑ Public ☑ Community

Comments:/Conditions: * ONE INSPECTION port per LATERAL
Remove any old balmy terraces.
10-22-99 Rec'd revised house plan - substantially in compliance w/ IP - House to be located where shown. DSH

Comments:/Conditions:

INITIAL SITE SKETCH

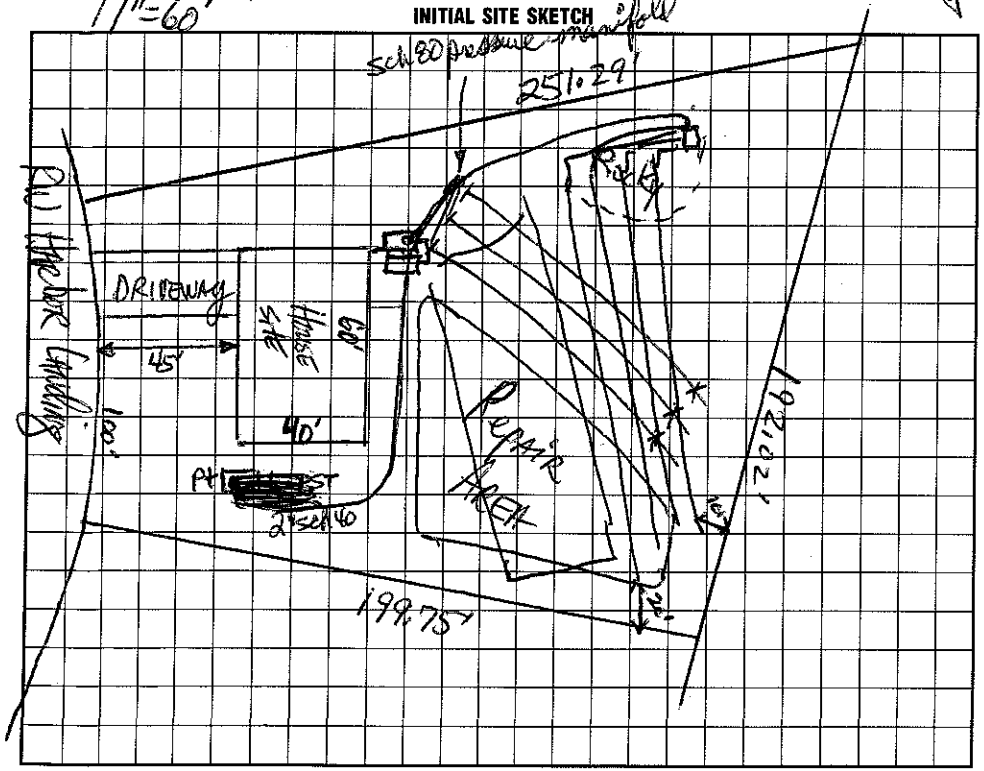

AS BUILT SKETCH

I understand that this permit can be suspended or revoked if any false information is supplied toward securing the permit/any unauthorized changes are made to the site/any unauthorized changes are made in the installation of the system. Improvement Permit with plat valid without expiration. Improvement Permit with site plan valid for sixty months. Authorization to Construct is valid for a period equal to that of Improvement Permit – not to exceed sixty months.

Signed: date 11/25/98 Installed by: Larry Beam

Improvement Permit by: date 11-21-98 Operation Permit by: RSI date 7/20/00

Authorization to Construct by: date 10-22-99 Existing System Inspection by: date

HEALTH DEPT. COPY: WHITE INSPECTION COPY (FINAL): GREEN OWNER COPY (FINAL): YELLOW INSPECTION COPY (INITIAL): PINK OWNER COPY (INITIAL): GOLD